

PEARL RIVER
 V 2032
 12-26-75

MISSISSIPPI
 BOARD OF WATER COMMISSIONERS
 416 North State Street
 Jackson, Mississippi 39201

WATER WELL DRILLERS LOG

12/24 1976 Bud Benton & Son Pearl River
 date well completed firm name county well located

LANDOWNER: AC Huey
RT 1 Carrier
 (mailing address)

description of formations encountered	from	to
Red Shale	0	39
Blue Shale	39	140
White Sand	140	180


WELL LOCATION:
 sec. 9 T. 5 N. R. 17 E
5 miles East of Carrier
 (distance) (direction) (nearest town)

WELL PURPOSE: home
 (home, irrigation, municipal, industrial)

- WELL COMPLETION DATA:
- (1) diameter (inches) 4"
 - (2) total depth (feet) 180
 - (3) static water level (feet) 72 below top of ground.
 - (4) casing PVC, 170
 (material) (depth)
4" if telescope see back.
 (size)
 - (5) screen 4x10, 170
 (length) (depth to top)
1/2" (size) PVC (material)
 - (6) pump 1/2 850 Sagin
 (HP) (yield gpm)
Elect (type power)
 - (7) electric log no
 (yes or no)
- (organization running log)


(8) how well bottom plugged Sand Sharp

DRILLERS REMARKS:

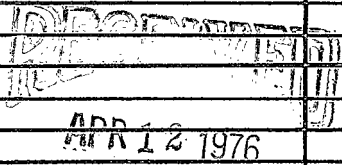

If well telescopes please sketch and show depths.

GROUND LEVEL

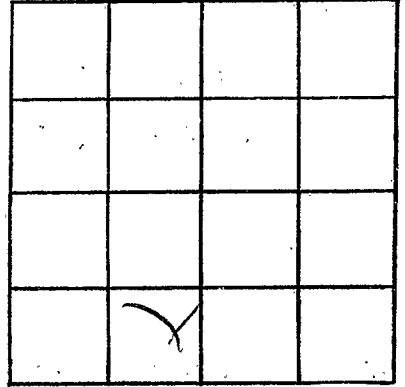

SECTION _____

Please indicate well location X.

ADDITIONAL INFORMATION

If more than one screen,
show locations of each on sketch.