

PEARL River
 V 2033
 1-30-76

MISSISSIPPI
 BOARD OF WATER COMMISSIONERS
 416 North State Street
 Jackson, Mississippi 39201

WATER WELL DRILLERS LOG

1/30 1976 Bud Perkinson Pearl River
 date well completed firm name county well located

LANDOWNER: Barrell Bodman

Mrs. Neil Mass

(mailing address)

description of formations encountered

white shale
 white sand
 blue shale
 blue sand

from to

0 21
 21 90
 90 200
 200 235

WELL LOCATION:

sec 9 T 5 N R 16 E
 3 miles East of Carriere
 (distance) (direction) (nearest town)

WELL PURPOSE: home
 (home, irrigation, municipal, industrial)


WELL COMPLETION DATA:

- (1) diameter (inches) 2
- (2) total depth (feet) 235
- (3) static water level (feet) 14 below top of ground.
- (4) casing 2" (material), 235' (depth)
 2' (size) if telescope see back.
- (5) screen 2x5' (length), 230' (depth to top)
 12" (size), 1/2" steel (material)
- (6) pump 1/2 HP (HP), 450 gpm (yield gpm)
 Elect (type power)
- (7) electric log no (yes or no)

(organization running log)

(8) how well bottom plugged Sand Shovel


DRILLERS REMARKS:

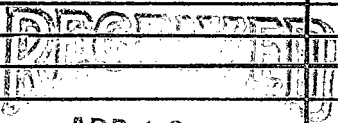

APR 12 1976

If well telescopes please sketch and show depths.

GROUND LEVEL

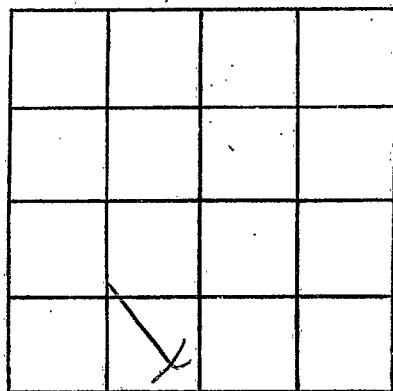

SECTION _____

Please indicate well location X.

ADDITIONAL INFORMATION

If more than one screen,
show locations of each on sketch.