

PEARL RIVER
 V 2034
 3-12-76

MISSISSIPPI
 BOARD OF WATER COMMISSIONERS
 416 North State Street
 Jackson, Mississippi 39201

WATER WELL DRILLERS LOG

3/12/76 ^{13V} date well completed
 Helix Petroleum firm name
 Pearl River county well located

LANDOWNER: Joe Burks
 B T 7

description of formations encountered	from	to
Red shale	0	91
Blue shale	91	280
Gray sand	280	350
Blue shale	350	460
Gray sand	460	574

(mailing address)

WELL LOCATION:
 sec. 13 T 43 N R 18 E
 6 miles E of Osborne
 (distance) (direction) (nearest town)

WELL PURPOSE: home
 (home, irrigation, municipal, industrial)


- WELL COMPLETION DATA:
- diameter (inches) 2 1/2
 - total depth (feet) 574
 - static water level (feet) 135 below top of ground.
 - casing 2 1/2" (material), 504 (depth)
 2" (size) if telescope see back.
 - screen 2 1/2" (length), 504 (depth to top)
 1/2" (size), 1" steel (material)
 - pump (HP) (yield gpm)
 (type power)
 - electric log no (yes or no)
 (organization running log)
 - how well bottom plugged Sand Shark

DRILLERS REMARKS:
 no pump furnished

RESERVATION
 APR 16 1976

If well telescopes please sketch and show depths.

GROUND LEVEL

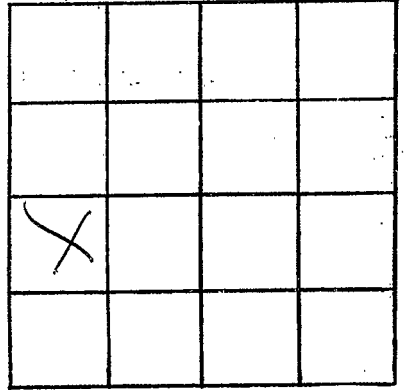

SECTION _____

Please indicate well location X.

ADDITIONAL INFORMATION

If more than one screen, show locations of each on sketch.