

Pearl River  
 ✓ 2035  
 4-17-76

MISSISSIPPI  
 BOARD OF WATER COMMISSIONERS  
 416 North State Street  
 Jackson, Mississippi 39201

WATER WELL DRILLERS LOG

H-17 1976 Lempkin Well Co Pearl River  
 date well completed firm name county well located

LANDOWNER:  
 Mr. Carl Ceculle  
 7136 E. HERMES  
 New Orleans, La. 70126  
 (mailing address)

description of formations encountered	from	to
Clay	0	60
Sand	60	95
Clay	95	180
Sand	180	226

WELL LOCATION:  
 sec. 9 T. 5 N. R. 16 E.  
 3 miles E. of Carriere  
 (distance) (direction) (nearest town)

WELL PURPOSE: Home.  
 (home, irrigation, municipal, industrial)


- WELL COMPLETION DATA:
- (1) diameter (inches) 2"
  - (2) total depth (feet) 226'
  - (3) static water level (feet) 30 below above top of ground.
  - (4) casing P.V.C. 220'  
 (material) (depth)  
 2" If telescope see back.  
 (size)
  - (5) screen 6' 220  
 (length) (depth to top)  
 2" P.V.C.  
 (size) (material)
  - (6) pump 1/2 350 GPH.  
 (HP) (yield gpm)  
 Elec.  
 (type power)
  - (7) electric log No.  
 (yes or no)
- (organization running log)
- (8) how well bottom plugged sand/shale

DRILLERS REMARKS:

JUN 21 1976  
 MISS. DEP. OF WATER CONTROL

If well telescopes please sketch and show depths.

GROUND LEVEL

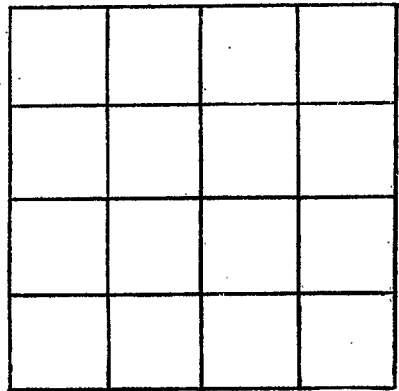

SECTION \_\_\_\_\_

Please indicate well location X.

ADDITIONAL INFORMATION

A series of horizontal lines providing space for additional information.

If more than one screen, show locations of each on sketch.