

Pearl River  
 V 2030  
 4-24-76

MISSISSIPPI  
 BOARD OF WATER COMMISSIONERS  
 416 North State Street  
 Jackson, Mississippi 39201

WATER WELL DRILLERS LOG

4-24-76 <sup>13V</sup> date well completed  
 1976 Pearl River firm name  
 Pearl River county well located

LANDOWNER: Hermon Logan

Route 2, Carriere Ms

(mailing address)

WELL LOCATION:

sec. 8 T 11 S N 10 E R 10 W  
3 1/4 miles East of Carriere  
 (distance) (direction) (nearest town)

WELL PURPOSE: Home  
 (home, irrigation, municipal, industrial)

WELL COMPLETION DATA:

- (1) diameter (inches) 2 1/2
- (2) total depth (feet) 357
- (3) static water level (feet) 45 below above top of ground.
- (4) casing PVC (material) (depth)

if telescope see back.  
 (size)

- (5) screen 2 x 10 247  
 (length) (depth to top)  
1/2 PVC  
 (size) (material)

- (6) pump 1 1/2 (HP) (yield gpm)  
electric  
 (type power)

- (7) electric log NO  
 (yes or no)

(organization running log)

- (8) how well bottom plugged and shank

description of formations encountered

description of formations encountered	from	to
Red shale	0	19
Sand	19	45
Blue shale	45	216
Blue sand	216	247
Blue shale	247	289
Blue sand	289	357


DRILLERS REMARKS:

RECEIVED  
 SEP 1 1976

MISS. Bd. OF WATER COMMISSIONERS

If well telescopes please sketch and show depths.

GROUND LEVEL

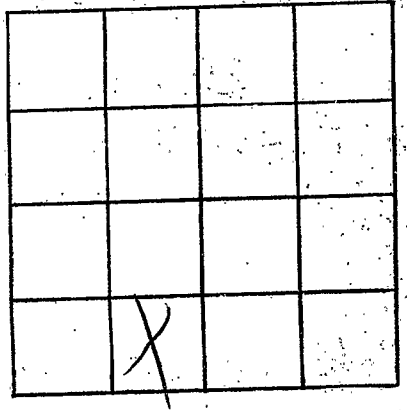

SECTION \_\_\_\_\_

Please indicate well location X.

ADDITIONAL INFORMATION

If more than one screen, show locations of each on sketch.