

Pearl River  
V 2038  
6-1-76

MISSISSIPPI  
 BOARD OF WATER COMMISSIONERS  
 416 North State Street  
 Jackson, Mississippi 39201

WATER WELL DRILLERS LOG

6-1 1976 Penton Well Sers Pearl River  
 date well completed firm name county well located

LANDOWNER: Marion Lee  
Rt. 2  
Carriere MS  
 (mailing address)

description of formations encountered	from	to
Surface clay	0	20
Red sand	20	30
Blue clay	30	155
Sand	155	178

WELL LOCATION:  
 sec 28 T 5 N R 16 E  
3 miles East of Carriere  
 (distance) (direction) (nearest town)

WELL PURPOSE: Home  
 (home, irrigation, municipal, industrial)


- WELL COMPLETION DATA:
- (1) diameter (inches) 2
  - (2) total depth (feet) 178
  - (3) static water level (feet) 13 below top of ground.
  - (4) casing Galv., 168,  
 (material) (depth)  
2" if telescope see back.  
 (size)
  - (5) screen 10', 168  
 (length) (depth to top)  
2, St. Steel  
 (size) (material)
  - (6) pump 1, 12  
 (HP) (yield gpm)  
Elec  
 (type power)
  - (7) electric log No  
 (yes or no)
  - (8) how well bottom plugged Ball Valve

DRILLERS REMARKS:

RECEIVED  
 JUL - 8 1976  
 MISS. Bd. OF WATER COMMISSIONERS

If well telescopes please sketch and show depths.

GROUND LEVEL

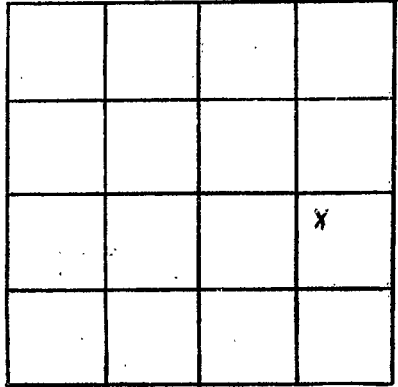

SECTION 28

Please indicate well location X.

ADDITIONAL INFORMATION

If more than one screen, show locations of each on sketch.