

Pearl River
 V 2035
 12-22-76

MISSISSIPPI
 BOARD OF WATER COMMISSIONERS
 416 North State Street
 Jackson, Mississippi 39201

WATER WELL DRILLERS LOG

12-22-1976 date well completed
 76 Pumpkin Well Co. firm name
 Pearl River county well located

LANDOWNER: Ed. Amero
 Anchor Lake
 Carrier, Ms. 39426
 (mailing address)

description of formations encountered	from	to
4-3 Clay	0	30
Sand	30	90
Clay	90	290
Sand	290	450

WELL LOCATION:
 sec. 8 T. 5 N. R. 16 E.
 2 miles East of Carrier
 (distance) (direction) (nearest town)

WELL PURPOSE: Home
 (home, irrigation, municipal, industrial)

- WELL COMPLETION DATA:
- (1) diameter (inches) 2"
 - (2) total depth (feet) 450 ft.
 - (3) static water level (feet) 60 ^{below} _{above} top of ground.
 - (4) casing P.V.C. 450
 (material) (depth)
 2" (size) if telescope see back.
 - (5) screen 6 ft. 444
 (length) (depth to top)
 2" P.V.C.
 (size) (material)
 - (6) pump 1 320 gal.
 (HP) (yield gpm/per hr.)
 Electric (type power)
 - (7) electric log No
 (yes or no)


(organization running log)
 (8) how well bottom plugged Sand
 Shanks

DRILLERS REMARKS:

RECEIVED
 JUN 20 1977
 MISS. BD. OF WATER COMMISSIONERS

If well telescopes please sketch and show depths.

GROUND LEVEL

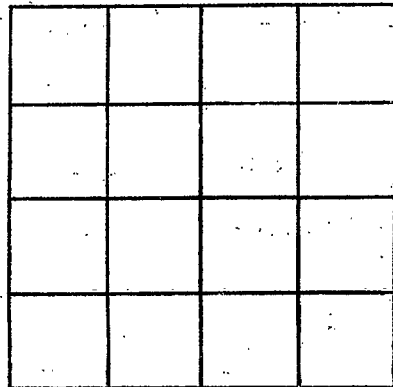

SECTION _____

Please indicate well location X.

ADDITIONAL INFORMATION

If more than one screen, show locations of each on sketch.