

Pearl River
V 2040
6-23-77

MISSISSIPPI
 BOARD OF WATER COMMISSIONERS
 416 North State Street
 Jackson, Mississippi 39201

13V

WATER WELL DRILLERS LOG

6/23 1977 Bud-penton & Son Pearl River
 date well completed firm name county well located

LANDOWNER: <u>James Webb</u>	description of formations encountered	from	to
<u>B.T. 3 Carrier</u>	<u>Red clay</u>	<u>0</u>	<u>77</u>
	<u>White sand</u>	<u>77</u>	<u>110</u>
	<u>Gray shale</u>	<u>110</u>	<u>270</u>
	<u>Gray sand</u>	<u>270</u>	<u>300</u>

(mailing address)
 WELL LOCATION:
 2 sec. 21 T. 5 N. R. 18 E
6 1/2 miles SE of Carrier
 (distance) (direction) (nearest town)

WELL PURPOSE: home
 (home, irrigation, municipal, industrial)

- WELL COMPLETION DATA:
- (1) diameter (inches) 2'
 - (2) total depth (feet) 300
 - (3) static water level (feet) 45' above top of ground.
 - (4) casing pvc 290
 (material) (depth)
 - (size) if telescope see back.
 - (5) screen 2x10 290
 (length) (depth to top)
 - 12 pvc
 (size) (material)
 - (6) pump 1 1/4 650
 (HP) (yield gpm)
 - Elut
 (type power)
 - (7) electric log no
 (yes or no)

(organization running log)

(8) how well bottom plugged sherk


DRILLERS REMARKS:

RECEIVED

SEP 25 1977

If well telescopes please sketch and show depths.

GROUND LEVEL

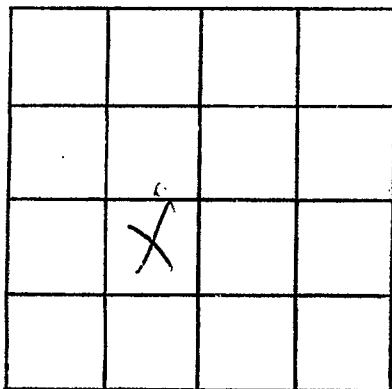

SECTION _____

Please indicate well location X.

ADDITIONAL INFORMATION

If more than one screen,
show locations of each on sketch.