

Pearl River
 V 2041
 1-26-77

MISSISSIPPI
 BOARD OF WATER COMMISSIONERS
 416 North State Street
 Jackson, Mississippi 39201

WATER WELL DRILLERS LOG

1-26-1977 date well completed
 1317 Memphis Well Drilling Pearl River county well located
 Stockwell Bros - firm name

LANDOWNER:
 Mr. Ed Kniffle
 Carrier, Miss
 (mailing address)

description of formations encountered	from	to
Clay	0	30
Sand	30	60
Clay	60	90
fine Sand	90	105
Clay	105	200
Sand	200	243

WELL LOCATION:
 sec. 9 T N R 16 E
 2 5 S 16 W
 (distance) miles East of Carrier (direction) (nearest town)

WELL PURPOSE: Home
 (home, irrigation, municipal, industrial)


- WELL COMPLETION DATA:
- (1) diameter (inches) 2"
 - (2) total depth (feet) 243'
 - (3) static water level (feet) 45' below top of ground.
 - (4) casing PVC, 233' (material) (depth)
 2" (size) If telescope see back.
 - (5) screen 10', 233' (length) (depth to top)
 2", PVC (size) (material)
 - (6) pump 1/2 230 GPH (HP) (yield gpm)
 Electric (type power)
 - (7) electric log No (yes or no)
- (organization running log)
- (8) how well bottom plugged Sand sharp

DRILLERS REMARKS:

RECEIVED
 JUN 20 1977
 MISS. BD OF WATER COMMISSIONERS

If well telescopes please sketch and show depths.

GROUND LEVEL

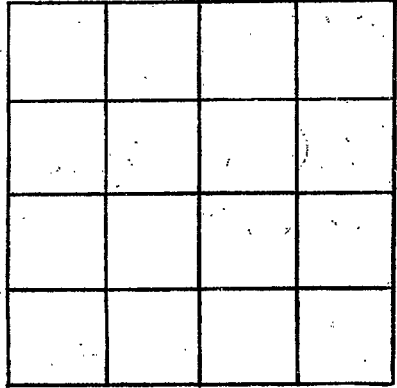

SECTION _____

Please indicate well location X.

ADDITIONAL INFORMATION

If more than one screen,
show locations of each on sketch.