

Pearl River
 V 2042
 5-9-77

MISSISSIPPI
 BOARD OF WATER COMMISSIONERS
 416 North State Street
 Jackson, Mississippi 39201

WATER WELL DRILLERS LOG

5-9-77 date well completed 1977 firm name Pearl River county well located

LANDOWNER:
 Mrs. Dorothy Perkins
 Carrier, Miss.
 (mailing address)

description of formations encountered	from	to
Clay	0	30
Sand	30	85
Clay	85	290
Sand	290	350

WELL LOCATION:
 sec. 28 T 5 N R 16 E
 3 miles East of Carrier
 (distance) (direction) (nearest town)

WELL PURPOSE: Home
 (home, irrigation, municipal, industrial)

- WELL COMPLETION DATA:
- (1) diameter (inches) 2"
 - (2) total depth (feet) 350'
 - (3) static water level (feet) 30' below top of ground.
 - (4) casing P.V.C. 340'
 (material) (depth)
 2" (size) if telescope see back.
 - (5) screen 10' 340'
 (length) (depth to top)
 2" P.V.C.
 (size) (material)
 - (6) pump 1/2 250 GPH.
 (HP) (yield gpm)
 Electric
 (type power)
 - (7) electric log No
 (yes or no)

(organization running log)
 (8) how well bottom plugged Sand
 Shale


DRILLERS REMARKS:

RECEIVED
 JUN 17 1977

MISS. Bd. OF WATER COMMISSIONERS

If well telescopes please sketch and show depths.

GROUND LEVEL

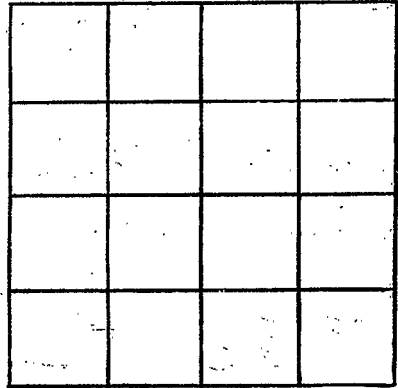

SECTION _____

Please indicate well location X.

ADDITIONAL INFORMATION

If more than one screen, show locations of each on sketch.