

Pearl River
V 2043
7-14-77

MISSISSIPPI
 BOARD OF WATER COMMISSIONERS
 416 North State Street
 13V Jackson, Mississippi 39201

WATER WELL DRILLERS LOG

7/14 1977
 date well completed

Pooney water well
 firm name

Pearl River
 county well located

LANDOWNER: Daryl Thompson

description of formations encountered

from

to

Port in metals
Rt. 1 Pooney 39466
 (mailing address)

Clay
sd clay unit
sd -

| | |
|----|----|
| 0 | 20 |
| 20 | 36 |
| 36 | 67 |

WELL LOCATION:

sec 17 T 5 N R 16 E
5 miles NE of Pooney
 (distance) (direction) (nearest town)

WELL PURPOSE: Farm Use
 (home, irrigation, municipal, industrial)

WELL COMPLETION DATA:

- (1) diameter (inches) 2
- (2) total depth (feet) 67
- (3) static water level (feet) 33 below above top of ground
- (4) casing PVC 57
 (material) (depth)
2 if telescope see back.
 (size)
- (5) screen 10 57
 (length) (depth to top)
2 PVC
 (size) (material)
- (6) pump 3/4 4
 (HP) (yield gpm)
AC Generator
 (type power)
- (7) electric log _____
 (yes or no)

(organization running log)

(8) how well bottom plugged Sand

DRILLERS REMARKS:


RECEIVED

AUG 26 1977

MISS. Bd. OF WATER COMMISSIONERS

If well telescopes please sketch and show depths.

GROUND LEVEL

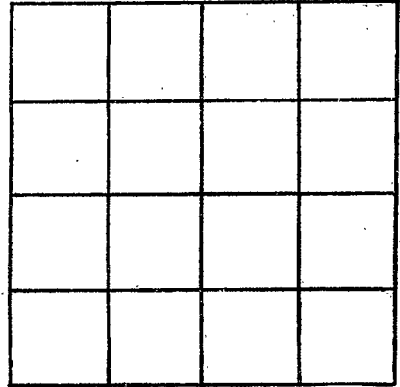

SECTION _____

Please indicate well location X.

ADDITIONAL INFORMATION

If more than one screen, show locations of each on sketch.