

Pearl River
V 2044
7-22-77

MISSISSIPPI
 BOARD OF WATER COMMISSIONERS
 416 North State Street
 Jackson, Mississippi 39201

WATER WELL DRILLERS LOG
 STOCKSTILL BROS., INC.

7-22 1977 firm name Pearl River county well located

LANDOWNER:
Mr. Martin Lalardo
2226 Corrine Ave
Chalmette, La
 Anchor Lake - (mailing address)

description of formations encountered	from	to
Clay	0	10
Sand	10	25
Clay	25	110
Sand	110	240

WELL LOCATION:
 sec. 8 T N R 7E
3 miles SE of Caniel
 (distance) (direction) (nearest town)

WELL PURPOSE: Home
 (home, irrigation, municipal, industrial)


- WELL COMPLETION DATA:
- (1) diameter (inches) 2"
 - (2) total depth (feet) 240'
 - (3) static water level (feet) 15' below above top of ground.
 - (4) casing PVC, 235'
 (material) (depth)
2" if telescope see back.
 (size)
 - (5) screen 5', 235'
 (length) (depth to top)
2", P.V.C.
 (size) (material)
 - (6) pump 1/2, 22
 (HP) (yield gpm)
Elec.
 (type power)
 - (7) electric log No
 (yes or no)
No
 (organization running log)
 - (8) how well bottom plugged Good

RECEIVED
 SEP 22 1977
 MISS. Bd. OF WATER COMMISSIONERS

DRILLERS REMARKS:

If well telescopes please
sketch and show depths.

GROUND LEVEL

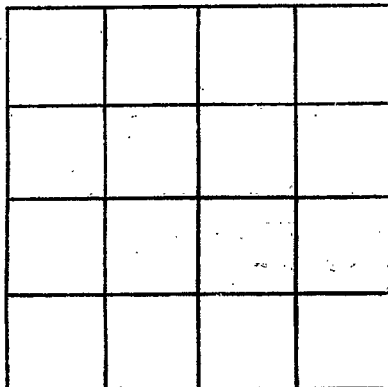

SECTION _____

Please indicate well location X.

ADDITIONAL INFORMATION

If more than one screen,
show locations of each on sketch.