

Pearl River  
V 20461  
10-5-77

MISSISSIPPI  
 BOARD OF WATER COMMISSIONERS  
 416 North State Street  
 Jackson, Mississippi 39201

WATER WELL DRILLERS LOG

10-5 1977 Stockstill Bros. Pearl River  
 date well completed firm name county well located

LANDOWNER:  
Mr. Daniel Roster  
Carriere, Miss.  
Anchor Lake (mailing address)

description of formations encountered	from	to
Clay	0	15
Sand	15	30
Clay	30	120
Sand	120	130
Clay	130	190
Sand	190	220

WELL LOCATION:  
 sec. 17 T. N R. 16 E  
5 S 17 W  
3 miles E of Carriere  
 (distance) (direction) (nearest town)

WELL PURPOSE: Home  
 (home, irrigation, municipal, industrial)

- WELL COMPLETION DATA:
- (1) diameter (inches) 2"
  - (2) total depth (feet) 220'
  - (3) static water level (feet) 25' below above top of ground.
  - (4) casing P.V.C., 215'  
 (material) (depth)  
2" if telescope see back.  
 (size)
  - (5) screen 5', 215'  
 (length) (depth to top)  
2", P.V.C.  
 (size) (material)
  - (6) pump 1/2 11  
 (HP) (yield gpm)  
Elec.  
 (type power)
  - (7) electric log No  
 (yes or no)  
No  
 (organization running log)
  - (8) how well bottom plugged Sand Shells


DRILLERS REMARKS:

**RECEIVED**  
 OCT 11 1977

MISSISSIPPI WATER COMMISSION

If well telescopes please sketch and show depths.

GROUND LEVEL

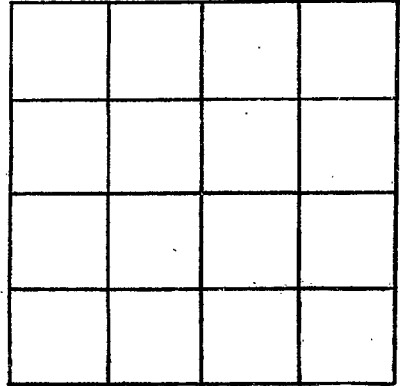

SECTION \_\_\_\_\_

Please indicate well location X.

ADDITIONAL INFORMATION

If more than one screen, show locations of each on sketch.