

PEAR RIVER

V 2047

MISSISSIPPI  
BOARD OF WATER COMMISSIONERS  
416 North State Street  
Jackson, Mississippi 39201

WATER WELL DRILLERS LOG

12-8-1977  
date well completed

77 Stachiel Bros. Co.  
firm name

Pear River  
county well located

LANDOWNER:

David Snyder

5808 Lapreniere St.  
Metairie, La. (mailing address) 70003

WELL LOCATION:

sec. 9 T 5 N R 16 E  
3 miles E of Camiere  
(distance) (direction) (nearest town)

WELL PURPOSE: Home  
(home, irrigation, municipal, industrial)

WELL COMPLETION DATA:

- (1) diameter (inches) 2"
- (2) total depth (feet) 368 ft.
- (3) static water level (feet) 30 <sup>below</sup> ~~above~~ top of ground.
- (4) casing P.V.C. 358'  
(material) (depth)  
2" (size) If telescope see back.
- (5) screen 10' 358'  
(length) (depth to top)  
2" P.V.C.  
(size) (material)
- (6) pump 1/2 350 G.P.H.  
(HP) (yield gpm)  
Elec.  
(type power)
- (7) electric log No  
(yes or no)

(organization running log)

(8) how well bottom plugged Sand  
shank

DRILLERS REMARKS:

description of formations encountered

from to


description of formations encountered	from	to
Clay	0	15
Sand	15	35
Clay	35	90
Sand	90	110
Clay	110	300
Sand	300	368

RECEIVED  
MAY 24 1979

MISS. DD. OF WATER COMMISSIONERS

If well telescopes please  
sketch and show depths.

GROUND LEVEL

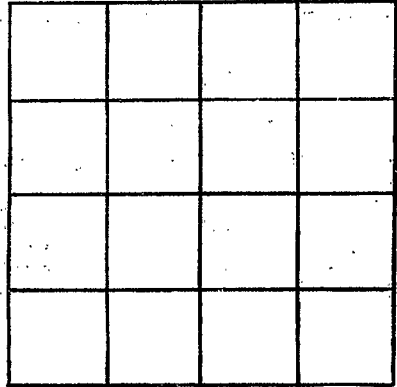

SECTION \_\_\_\_\_

Please indicate well location X.

ADDITIONAL INFORMATION

If more than one screen,  
show locations of each on sketch.