

PEARL RIVER

V V 2009

4-23-78

MISSISSIPPI BOARD OF WATER COMMISSIONERS
416 North State Street
Jackson, Mississippi 39201

WATER WELL DRILLERS LOG

April 23, 1978

Revue Water Well Pump, Inc.

Pearl River

date well completed

firm name

county well located

LANDOWNER: Ronald Joseph Yvonne

description of formations encountered

from

to

Route 2 - Box 135

Carrriere, Ms.

(mailing address)

Clay

0

75

Sand

75

105

WELL LOCATION:

sec 9 T 5 N R 16 E
(S) (W)

Clay

105

175

2 miles E of Carrriere
(distance) (direction) (nearest town)

Sand

175

220

WELL PURPOSE: Home
(home, irrigation, municipal, industrial)

WELL COMPLETION DATA:

(1) diameter (inches) 4

(2) total depth (feet) 220

(3) static water level (feet) 18' below
top of ground. (above)

(4) casing P.V.C., 210
(material) (depth)

4"
(size) if telescope see back.

(5) screen 10', 220'
(length) (depth to top)

4", P.V.C.
(size) (material)

(6) pump 1, 15
(HP) (yield gpm)

ELECT.
(type power)

(7) electric log NO
(yes or no)

(organization running log)

(8) how well bottom plugged Sand Blank


DRILLERS REMARKS:

RECEIVED
MAY 2 - 1978

MISS. BD. OF WATER COMMISSIONERS

If well telescopes please sketch and show depths.

GROUND LEVEL

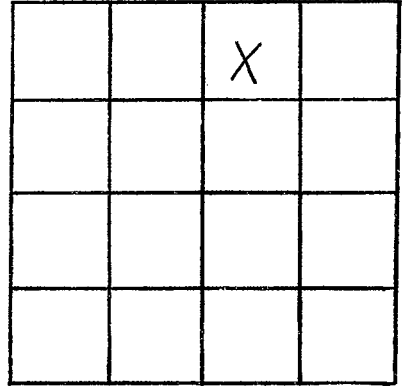

SECTION 9

Please indicate well location X.

ADDITIONAL INFORMATION

If more than one screen,
show locations of each on sketch.