

PEARL RIVER

V 2050

3/6/78

MISSISSIPPI BOARD OF WATER COMMISSIONERS
416 North State Street
Jackson, Mississippi 39201

WATER WELL DRILLERS LOG

3/6 1978 *Paul G. ...* *Pearl River*
date well completed firm name county well located

LANDOWNER: *Dr. ...*
R.2 Box
Carrier Miss.
(mailing address)

description of formations encountered	from	to
<i>Red Shale</i>	<i>0</i>	<i>35"</i>
<i>Red Lignite</i>	<i>35</i>	<i>60</i>
<i>Blk Shale</i>	<i>60</i>	<i>130</i>

WELL LOCATION:
sec. 13 T. 5 N R. 16 E
S W
4 miles E of Carrier
(distance) (direction) (nearest town)

WELL PURPOSE: home
(home, irrigation, municipal, industrial)

- WELL COMPLETION DATA:
- (1) diameter (inches) 2 1/2
 - (2) total depth (feet) 188
 - (3) static water level (feet) 22 below above top of ground.
 - (4) casing POC 1 1/2 (material) 188 (depth)
NO (size) if telescope see back.
 - (5) screen 2x10 178 (length) (depth to top)
1 1/2 POC (size) (material)
 - (6) pump 1/2 (HP) 400 (yield gpm)
Elect (type power)
 - (7) electric log NO (yes or no)

(organization running log)

(8) how well bottom plugged bed


DRILLERS REMARKS: *Shark*

RECEIVED
JUL 14 1978

MISS. Bd. OF WATER COMMISSIONERS

If well telescopes please sketch and show depths.

GROUND LEVEL

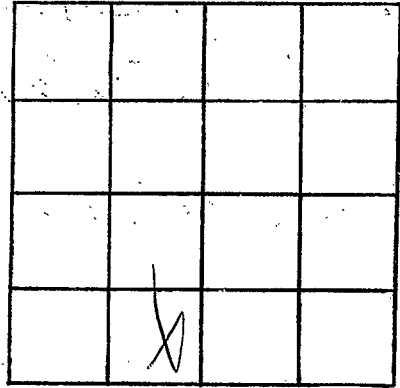

SECTION _____

Please indicate well location X.

ADDITIONAL INFORMATION

A series of horizontal lines for writing additional information, starting below the 'ADDITIONAL INFORMATION' header and extending to the bottom of the page.

If more than one screen, show locations of each on sketch.