

PEARL RIVER

V 2051

MISSISSIPPI
 BOARD OF WATER COMMISSIONERS
 416 North State Street
 Jackson, Mississippi 39201

WATER WELL DRILLERS LOG

574 1978 Bud Perton & Son Pearl River
 date well completed firm name county well located

LANDOWNER: Mr Fred Cruse
P.O. Box
Carriere Miss.
 (mailing address)

description of formations encountered	from	to
Red shale	0	45
White sand	45	60
Blue shale	60	200
Bray sand	200	240

WELL LOCATION:
 sec. 9 T. 5 N R. 16 E
4 miles East of Carriere
 (distance) (direction) (nearest town)


WELL PURPOSE: home
 (home, irrigation, municipal, industrial)

- WELL COMPLETION DATA:
- (1) diameter (inches) 2"
 - (2) total depth (feet) 240
 - (3) static water level (feet) 35 ^{below} ~~above~~ top of ground.
 - (4) casing PVC, 230
 (material) (depth)
 (size) if telescope see back.
 - (5) screen 2x10, 230
 (length) (depth to top)
12, PVC
 (size) (material)
 - (6) pump 1, 550
 (HP) (yield gpm)
Elect.
 (type power)
 - (7) electric log no
 (yes or no)

(organization running log)

(8) how well bottom plugged
Sand sharp


DRILLERS REMARKS:

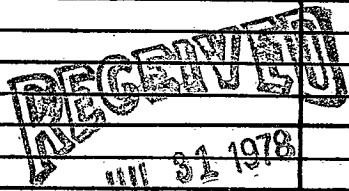

MISS. BD. OF WATER COMM.

If well telescopes please sketch and show depths.

GROUND LEVEL

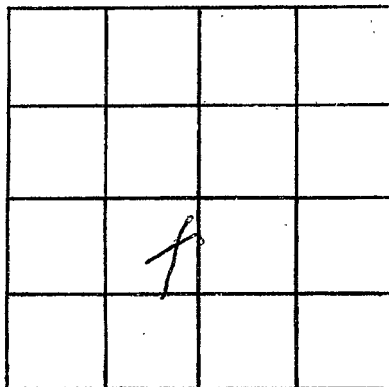

SECTION _____

Please indicate well location X.

ADDITIONAL INFORMATION

If more than one screen,
show locations of each on sketch.