

PEARL RIVER

V 2052

MISSISSIPPI  
BOARD OF WATER COMMISSIONERS  
416 North State Street  
Jackson, Mississippi 39201

WATER WELL DRILLERS LOG

6-22-78  
date well completed

Bud Peterson  
firm name

Pearl River  
county well located

LANDOWNER:	description of formations encountered	from	to
Robert Pierce Carrine, Mo. (mailing address)			
	red sand	35	60
	blue shale	60	130
	grey sand	130	135

WELL LOCATION:  
 sec. 9 T 5 N R 16 E  
 S W  
 2 miles E of Carrine  
 (distance) (direction) (nearest town)

WELL PURPOSE: Home  
 (home, irrigation, municipal, industrial)

- WELL COMPLETION DATA:
- (1) diameter (inches) 2 in
  - (2) total depth (feet) 155
  - (3) static water level (feet) 28 below top of ground.
  - (4) casing PVC 155 (material) (depth)
  - (size) if telescope see back.
  - (5) screen 2x10 145 (length) (depth to top)
  - 12 PVC (size) (material)
  - (6) pump 1 550 (HP) (yield gpm)
  - electric (type power)
  - (7) electric log NO (yes or no)
  - (organization running log)


(8) how well bottom plugged  
 sand shale

DRILLERS REMARKS:

RECEIVED  
 JUN 31 1978

If well telescopes please sketch and show depths.

GROUND LEVEL

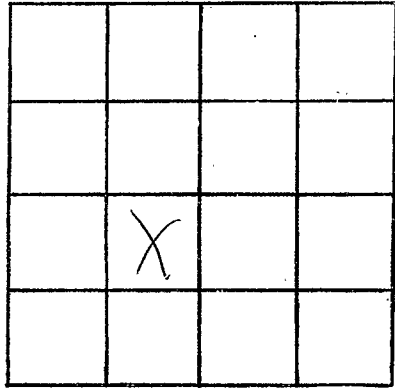

SECTION \_\_\_\_\_

Please indicate well location X.

ADDITIONAL INFORMATION

If more than one screen,  
show locations of each on sketch.