

PEARL RIVER
 V 2053
 12-18-78

MISSISSIPPI
 BOARD OF WATER COMMISSIONERS
 416 North State Street
 Jackson, Mississippi 39201

WATER WELL DRILLERS LOG

12/18 1978 Budgerston Pearl River
 date well completed firm name county well located

LANDOWNER: Nichols
Donovan M. Set 10
Archer Lake Carrington
 (mailing address)

WELL LOCATION:
 sec. 9 T 5 N R 16 E
3 miles East of Carrington
 (distance) (direction) (nearest town)

WELL PURPOSE: home
 (home, irrigation, municipal, industrial)


WELL COMPLETION DATA:
 (1) diameter (inches) 2 1/2
 (2) total depth (feet) 237
 (3) static water level (feet) 37 below/above top of ground.
 (4) casing Galv., 228,
 (material) (depth)
no if telescope see back.
 (size)
 (5) screen 2x10, 228
 (length) (depth to top)
12, SS Steel
 (size) (material)
 (6) pump 1 650
 (HP) (yield_gpm)
Elect. 90%
 (type power)
 (7) electric log no
 (yes or no)

(organization running log)

(8) how well bottom plugged
Sand Shale

DRILLERS REMARKS:

| description of formations encountered | from | to |
|---------------------------------------|------|-----|
| Red Shale | 0 | 60 |
| Red Sand | 60 | 95 |
| Blue Shale | 95 | 200 |
| Blue Sand | 200 | 237 |

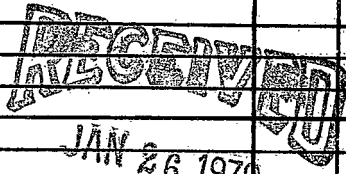


JAN 26 1979

MISS. BD. OF WATER COMM

If well telescopes please
sketch and show depths.

GROUND LEVEL

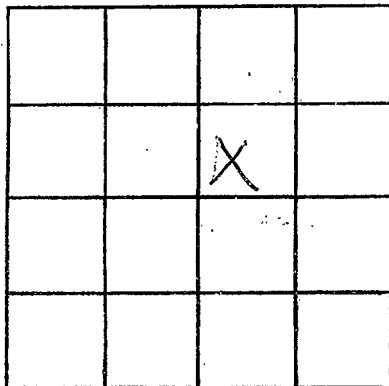

SECTION _____

Please indicate well location X.

ADDITIONAL INFORMATION

If more than one screen,
show locations of each on sketch.