

PEARL RIVER
 V 2024
 10-27-78

MISSISSIPPI
 BOARD OF WATER COMMISSIONERS
 416 North State Street
 Jackson, Mississippi 39201

WATER WELL DRILLERS LOG

10/27 1978 Bud Denton & Son Pearl River
 date well completed firm name county well located

LANDOWNER: Michel Seluy
 Po Box 9499
 Miss
 (mailing address)

description of formations encountered	from	to
Red shale	0	32
White sand	32	70
Blue shale	70	160
White sand	160	210
Blue shale	210	220
Gravel	220	250

WELL LOCATION:
 sec. 6 T 5 N R 16 E
 S W
 4 3/4 miles North of Poplarville
 (distance) (direction) (nearest town)


WELL PURPOSE: home
 (home, irrigation, municipal, industrial)

- WELL COMPLETION DATA:
- (1) diameter (inches) 4 1/2
 - (2) total depth (feet) 250
 - (3) static water level (feet) 28 below above top of ground.
 - (4) casing PVC 740 (material) (depth)
 4x2 if telescope see back. (size)
 - (5) screen 10 740 (length) (depth to top)
 12 PVC (size) (material)
 - (6) pump 1/2 800 (HP) (yield gpm)
 Elect (type power) 90H
 - (7) electric log no (yes or no)

(organization running log)

(8) how well bottom plugged
 sand shark

DRILLERS REMARKS:

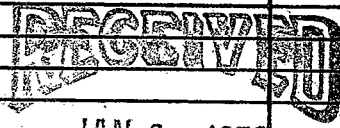


JAN 26 1978

MISS. BD. OF WATER COMMISSIONERS

If well telescopes please sketch and show depths.

GROUND LEVEL

← 620.2" →
← 15130 →
→ 41"

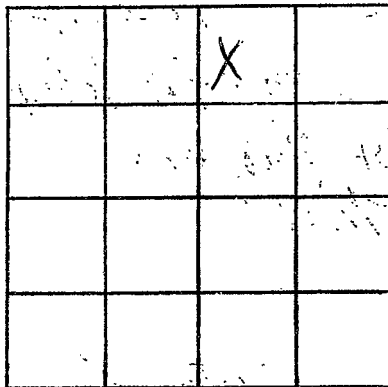

SECTION _____

Please indicate well location X.

ADDITIONAL INFORMATION

If more than one screen, show locations of each on sketch.