

V 2055  
 Pearl River  
 7-21-79

MISSISSIPPI  
 BOARD OF WATER COMMISSIONERS  
 416 North State Street  
 Jackson, Mississippi 39201

WATER WELL DRILLERS LOG

BOUNCEY WATER WELL DRILLING Pearl River  
 date well completed 7-21-79 firm name county well located

LANDOWNER: Tommy R. BO  
CARRIERS ROAD  
P. City, MS  
 (mailing address)

description of formations encountered	from	to
sd mix clay-	0	90
clay - mt. shales	90	260
soft mt. silt -	260	332

WELL LOCATION:  
 sec. 9 T. 5 N. R. 16 E  
7 miles N of P. City, MS  
 (distance) (direction) (nearest town)

WELL PURPOSE:  
 (home, irrigation, municipal, industrial)

- WELL COMPLETION DATA:
- (1) diameter (inches) 2
  - (2) total depth (feet) 332
  - (3) static water level (feet) 112 below above top of ground.
  - (4) casing PVC, 332,  
 (material) (depth)  
2 if telescope see back.  
 (size)
  - (5) screen 10, 322  
 (length) (depth to top)  
2, PVC  
 (size) (material)
  - (6) pump 1, 6  
 (HP) (yield gpm)  
nc  
 (type power)
  - (7) electric log /  
 (yes or no)  
 (organization running log)
  - (8) how well bottom plugged Sealed.

DRILLERS REMARKS: Fair


DEPT. OF NATURAL RESOURCES  
 BUREAU OF LAND & WATER RESOURCES

DEC 13 1979

RECEIVED

If well telescopes please sketch and show depths.

GROUND LEVEL

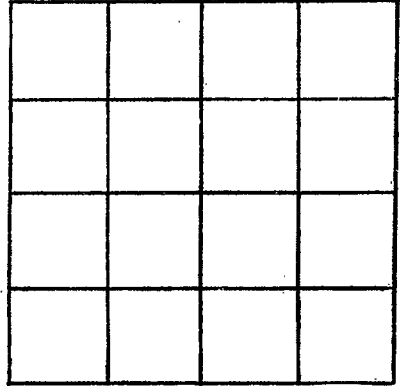

SECTION \_\_\_\_\_

Please indicate well location X.

ADDITIONAL INFORMATION

If more than one screen, show locations of each on sketch.