

Pearl River
V2058
10-30-79

MISSISSIPPI
BOARD OF WATER COMMISSIONERS
416 North State Street
Jackson, Mississippi 39201

WATER WELL DRILLERS LOG

Oct. 31, 1979 date well completed
Divie Water Well & Pump, Inc. Pearl River firm name
county well located

LANDOWNER: D. J. Griffin
2320 West Mere St.
Harvey, La.
(mailing address)

description of formations encountered	from	to
<u>Blue Clay</u>	<u>0</u>	<u>63</u>
<u>Sand + Clay</u>	<u>63</u>	<u>73</u>
<u>Coarse Sand</u>	<u>73</u>	<u>118</u>

WELL LOCATION:
sec. 4 T. 5 N. R. 16 E.
4 miles East of Garrison
(distance) (direction) (nearest town)

WELL PURPOSE: None
(home, irrigation, municipal, industrial)

WELL COMPLETION DATA:

- (1) diameter (inches) 2"
- (2) total depth (feet) 118'
- (3) static water level (feet) 14' below top of ground.
- (4) casing P.V.C. 108'
(material) (depth)
2" If telescope see back.
(size)
- (5) screen 10" 118'
(length) (depth to top)
2" P.V.C.
(size) (material)
- (6) pump 1 10
(HP) (yield gpm)
Electric
(type power)
- (7) electric log No
(yes or no)

(organization running log)

(8) how well bottom plugged
Sand (sharp)


DRILLERS REMARKS:

DEPT. OF NATURAL RESOURCES
BUREAU OF LAND & WATER RESOURCES

NOV 5 1979
RECEIVED

If well telescopes please sketch and show depths.

GROUND LEVEL

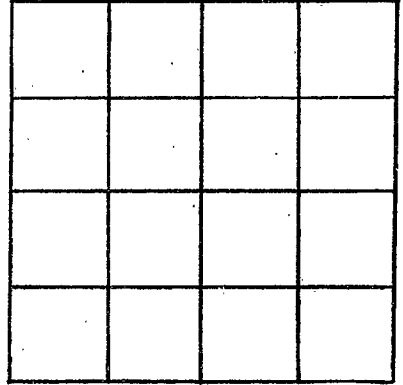

SECTION _____

Please indicate well location X.

ADDITIONAL INFORMATION

If more than one screen,
show locations of each on sketch.