

Pearl River
V 2060
5/23/80

MISSISSIPPI
BOARD OF WATER COMMISSIONERS
416 North State Street
Jackson, Mississippi 39201

WATER WELL DRILLERS LOG

Poundey Water Well Drilling

Pearl River

5-1
date well completed

1980

firm name

county well located

LANDOWNER: EVA TUTTLE
Rt 3,
Picayune RFD -
(mailing address)

description of formations encountered

from

to

WELL LOCATION:
sec. 1 T 5 N R 16 E
8 miles NE of Picayune
(distance) (direction) (nearest town)

Top clay

0 10

sd. Br -

15 30

Clay -

30 35

sd. Br -

35 40

Clay Blue -

40 100

sd. to Pine -

100 118

WELL PURPOSE: Home -
(home, irrigation, municipal, industrial)

- WELL COMPLETION DATA:
- (1) diameter (inches) 2
 - (2) total depth (feet) 118
 - (3) static water level (feet) 74 below top of ground
 - (4) casing PVC 108 (material) (depth)
 - (size) If telescope see back.
 - (5) screen PVC 108 (length) (depth to top)
 - (size) (material)
 - (6) pump 1 7 (HP) (yield gpm)
 - Ac 220 (type power)
 - (7) electric log (yes or no)
 - (organization running log)
 - (8) how well bottom plugged Seal

DEPT. OF NATURAL RESOURCES
BUREAU OF LAND & WATER RESOURCES


MAY 19 1980

RECEIVED

DRILLERS REMARKS:

If well telescopes please sketch and show depths.

GROUND LEVEL

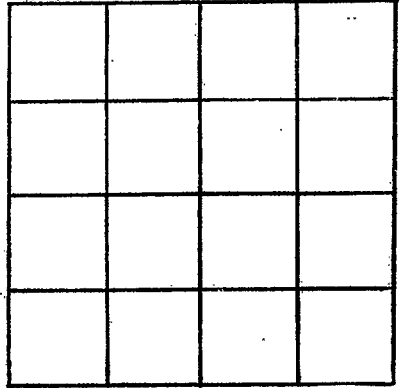

SECTION _____

Please indicate well location X.

ADDITIONAL INFORMATION

If more than one screen,
show locations of each on sketch.