

Pearl River
 V 2061
 5/23/80

MISSISSIPPI
 BOARD OF WATER COMMISSIONERS
 416 North State Street
 Jackson, Mississippi 39201

WATER WELL DRILLERS LOG

3/18 1980 Bud Denton Well Pearl River
 date well completed firm name county well located

LANDOWNER: Curtis Jones
 B.J. 2 Carriere
 Miss.
 (mailing address)

description of formations encountered	from	to
Red shale	0	60
White sand	60	75
White clay	75	135
White sand	135	185

WELL LOCATION: 16
 sec. 34 T 7 S R 16 E
 04 S East Carriere
 (distance) (direction) (nearest town)

WELL PURPOSE: home
 (home, irrigation, municipal, industrial)

- WELL COMPLETION DATA:
- (1) diameter (inches) 2"
 - (2) total depth (feet) 185
 - (3) static water level (feet) 22 below above top of ground.
 - (4) casing PVC 185
 (material) (depth)
 (size) if telescope see back.
 - (5) screen 10 175
 (length) (depth to top)
 12 PVC
 (size) (material)
 - (6) pump no
 (HP) (yield gpm)
 (type power)
 - (7) electric log no
 (yes or no)

(organization running log)
 (8) how well bottom plugged sand
 short


DRILLERS REMARKS:
 no pump furnished

DEPT. OF NATURAL RESOURCES
 BUREAU OF LAND & WATER RESOURCES

MAY 19 1980
 RECEIVED

If well telescopes please sketch and show depths.

GROUND LEVEL

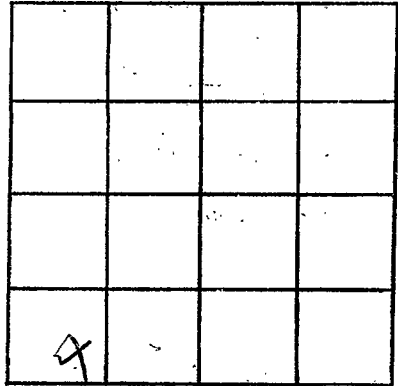

SECTION _____

Please indicate well location X.

ADDITIONAL INFORMATION

Lined area for additional information.

If more than one screen, show locations of each on sketch.