

Pearl River  
V 2062  
7/23/80

MISSISSIPPI  
BOARD OF WATER COMMISSIONERS  
416 North State Street  
Jackson, Mississippi 39201

WATER WELL DRILLERS LOG

7/23 1980 Paul Barber Pearl River  
date well completed Waters Well Service county well located

LANDOWNER: Paul A. Barber  
anchors lake  
P.O. carrier  
(mailing address)

| description of formations encountered | from | to  |
|---------------------------------------|------|-----|
| red shale                             | 0    | 60  |
| blue shale                            | 60   | 340 |
| gray sand                             | 340  | 370 |

WELL LOCATION:  
sec. 9 T-5 N R-16 E  
3 miles East of Carrier  
(distance) (direction) (nearest town)

WELL PURPOSE: home  
(home, irrigation, municipal, industrial)

- WELL COMPLETION DATA:
- (1) diameter (inches) 9"
  - (2) total depth (feet) 374
  - (3) static water level (feet) 42 below top of ground
  - (4) casing POC 364 (material) (depth)
  - (size) if telescope see back.
  - (5) screen 10 364 (length) (depth to top)
  - 12 POC (size) (material)
  - (6) pump 1/2 460 hr (HP) (yield gpm)
  - Elect (type power)
  - (7) electric log no (yes or no)

(organization running log)  
(8) how well bottom plugged

DRILLERS REMARKS:


DEPT. OF NATURAL RESOURCES  
BUREAU OF LAND & WATER RESOURCES

OCT - 8 1980

RECEIVED

If well telescopes please  
sketch and show depths.

GROUND LEVEL

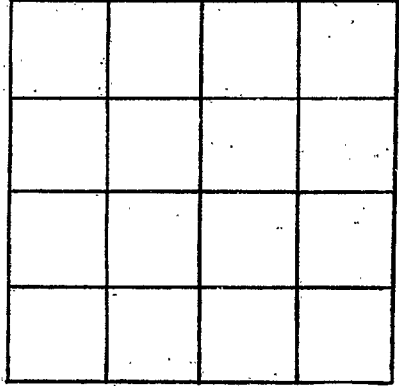

SECTION \_\_\_\_\_

Please indicate well location X.

ADDITIONAL INFORMATION

A series of horizontal lines for recording additional information, starting below the 'ADDITIONAL INFORMATION' header and extending down to the bottom of the page.

If more than one screen,  
show locations of each on sketch.