

PEARL River
 V 2063
 10-23-80

MISSISSIPPI
 BOARD OF WATER COMMISSIONERS
 416 North State Street
 Jackson, Mississippi 39201

WATER WELL DRILLERS LOG

10/23 1980 Bedenton Water Pearl River
 date well completed well drilled firm name county well located

LANDOWNER: Tommy Smith
 R.T. 2 Box Carrier
 Mill.
 (mailing address)

description of formations encountered	from	to
Red Shell	0	35
Blue Shale	35	160
Clay Sand	160	220

WELL LOCATION:
 sec. 26 T-5 N R-16 E
 6 miles East of Carriero
 (distance) (direction) (nearest town)

WELL PURPOSE: Home
 (home, irrigation, municipal, industrial)

- WELL COMPLETION DATA:
- (1) diameter (inches) 2"
 - (2) total depth (feet) 210
 - (3) static water level (feet) 60 below above top of ground.
 - (4) casing PVC, 200, (material) (depth)
 (size) if telescope see back.
 - (5) screen 10', 200 (length) (depth to top)
 12, PVC (size) (material)
 - (6) pump 1 hp, 530 gph (HP) (yield gpm)
 Elect (type power)
 - (7) electric log no (yes or no)

(organization running log)
 (8) how well bottom plugged: Hard

DRILLERS REMARKS:


DEPT. OF NATURAL RESOURCES
 BUREAU OF LAND & WATER RESOURCES

NOV 18 1980

RECEIVED

If well telescopes please sketch and show depths.

GROUND LEVEL

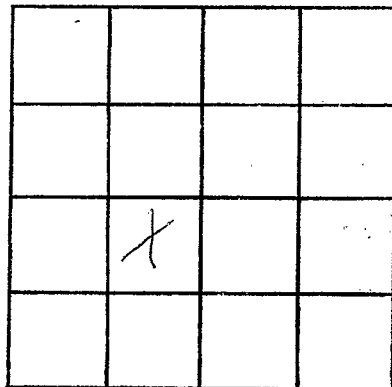

SECTION _____

Please indicate well location X.

ADDITIONAL INFORMATION

If more than one screen, show locations of each on sketch.