

Pearl Rv
 ✓ 2000
 6-13-81

MISSISSIPPI
 BOARD OF WATER COMMISSIONERS
 416 North State Street
 Jackson, Mississippi 39201

WATER WELL DRILLERS LOG

6-13 1981 Penton Well Serv Pearl River
 date well completed firm name county well located

LANDOWNER: David Lossett
 408 Woodgreen Cove
 Piquette, MS.
 (mailing address)


WELL LOCATION:
 sec 32 T 5 R 16
 S W
 2 1/2 miles N. E. of Piquette
 (distance) (direction) (nearest town)

WELL PURPOSE:
 (home, irrigation, municipal, industrial)

WELL COMPLETION DATA:

(1) diameter (inches) 2
 (2) total depth (feet) 682
 (3) static water level (feet) 4 below top of ground.
 (4) casing Galv. 672 (material) (depth)
 2 If telescope see back. (size)
 (5) screen 10' 672 (length) (depth to top)
 2 3. Steel (size) (material)
 (6) pump 1/2 10 (HP) (yield gpm)
 Elec (type power)
 (7) electric log NO (yes or no)
 (organization running log)
 (8) how well bottom plugged B. W. U. & S.


description of formations encountered	from	to
Surface Clay	0	30
Sand	30	30
Clay	30	390
Sand	390	430
Clay	430	480
Sand	480	682

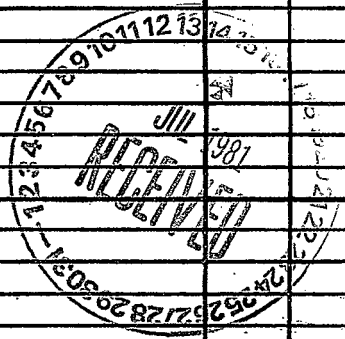

DRILLERS REMARKS:

If well telescopes please sketch and show depths.

GROUND LEVEL

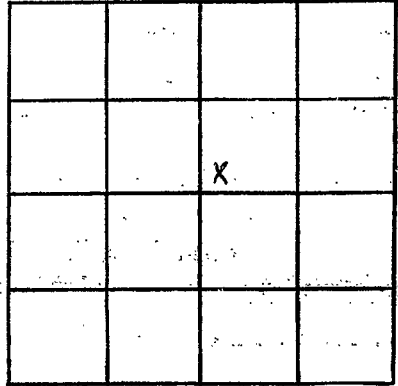

SECTION 33

Please indicate well location X.

ADDITIONAL INFORMATION

If more than one screen, show locations of each on sketch.