

MISSISSIPPI DEPARTMENT OF NATURAL RESOURCES

Bureau of Land and Water Resources

Southport Mall

P.O. Box 10631

Jackson, Mississippi 39209

WATER WELL DRILLERS LOG

BUD DENTON & SON
WATER WELL SERVICE

ROUTE 9 BOX 41

CARRIERS, MS 39426

PHONE 738-5324

PR

Pearl River
V 2008
6-25-81

6-25 19 81
date well completed

county well located

LANDOWNER: Chris - Orrell

description of formations encountered

from

to

Sycamore Ms.

<u>Gry. shale</u>	<u>0</u>	<u>45</u>
<u>White sand</u>	<u>45</u>	<u>60</u>
<u>Blue shale</u>	<u>60</u>	<u>180</u>
<u>Gry. sand</u>	<u>180</u>	<u>220</u>
<u>Blue shale</u>	<u>220</u>	<u>580</u>
<u>Blue sand</u>	<u>580</u>	<u>590</u>

(mailing address)

WELL LOCATION:

sec. 32 T 5 N R-16 E
3 miles E of Playas
(distance) (direction) (nearest town)

WELL PURPOSE: Home
(home, irrigation, municipal, industrial)

WELL COMPLETION DATA:

- (1) diameter (inches) 2
- (2) total depth (feet) 590
- (3) static water level (feet) 3 below above top of ground.
- (4) casing PVC 580
(material) (depth)

 If telescope see back.
(size)

- (5) screen 10 580
(length) (depth to top)

2 PVC
(size) (material)

- (6) pump 1/2 200
(HP) (yield gpm)

elec
(type power)

- (7) electric log
(yes or no)

(organization running log)

- (8) how well bottom plugged

DRILLERS REMARKS:


DEPT. OF NATURAL RESOURCES
BUREAU OF LAND & WATER RESOURCES

NOV 9 - 1981

RECEIVED

If well telescopes please sketch and show depths.

GROUND LEVEL

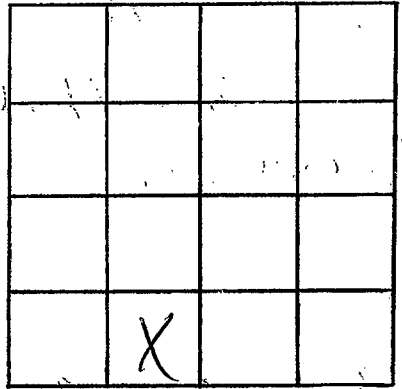

SECTION _____

Please indicate well location X.

ADDITIONAL INFORMATION

If more than one screen,
show locations of each on sketch.