

BOARD OF WATER COMMISSIONERS

416 North State Street

Jackson, Mississippi 39201

WATER WELL DRILLERS LOG

V 2071

4-15 date well completed

19 84 Ponton Well Service firm name

Pearl River county well located

LANDOWNER: Reggie Mitchell

Pl. ? Anchor Lake

Carriere MS. (mailing address)

description of formations encountered

from to

Surface Clay 0 340
Sand 340 383

WELL LOCATION:

sec 8 T 5 S R 16 E W
2 miles East Carriere (distance) (direction) (nearest town)

WELL PURPOSE: Home (home, irrigation, municipal, industrial)

WELL COMPLETION DATA:

- (1) diameter (inches) 2
- (2) total depth (feet) 383
- (3) static water level (feet) 42 below above top of ground
- (4) casing PVC 373 (material) (depth)
2 (size) if telescope see back.
- (5) screen 10' 373 (length) (depth to top)
2 PVC (size) (material)
- (6) pump 1 12 (HP) (yield gpm)
Elec (type power)
- (7) electric log NO (yes or no)

(organization running log)

(8) how well bottom plugged BW Valve

DRILLERS REMARKS:

DEPT. OF NATURAL RESOURCES
BUREAU OF LAND & WATER RESOURCES


MAY - 6 1962

RECEIVED

If well telescopes please sketch and show depths.

Drill Log

GROUND LEVEL

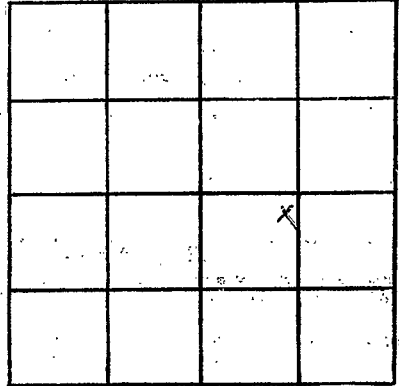

SECTION 8

Please indicate well location X.

ADDITIONAL INFORMATION

If more than one screen, show locations of each on sketch.