

MISSISSIPPI DEPARTMENT OF NATURAL RESOURCES

Bureau of Land and Water Resources

Southport Mall

P.O. Box 10631

Jackson, Mississippi 39209

WATER WELL DRILLERS LOG

Paul Kurek
V 2073

Nov 15 1982 date well completed 82 Walker Welding Service firm name Pearl River county well located

LANDOWNER Dorinda Bond
R.T. 6 Box 1090
Picayune Miss
(mailing address)

description of formations encountered

from to

Blue shale	0	36
Gravel	36	38
Sand	38	74

WELL LOCATION:

sec 30 T-5 S R-10 W
5 miles NE of Picayune
(distance) (direction) (nearest town)

WELL PURPOSE: None
(home, irrigation, municipal, industrial)

WELL COMPLETION DATA:

- (1) diameter (inches) 2"
- (2) total depth (feet) 74'
- (3) static water level (feet) 16' below top of ground.
- (4) casing PVC 64'
(material) (depth)
(size) if telescope see back.
- (5) screen 10' 64'
(length) (depth to top)
12 PVC
(size) (material)
- (6) pump 1 10
(HP) (yield gpm)
Elec
(type power)
- (7) electric log (yes or no) _____
(organization running log) _____
- (8) how well bottom plugged _____

DRILLERS REMARKS: Sand shale


DEPT OF NATURAL RESOURCES
BUREAU OF LAND & WATER RESOURCES

DEC 16 1982

RECEIVED

If well telescopes please
sketch and show depths.

GROUND LEVEL

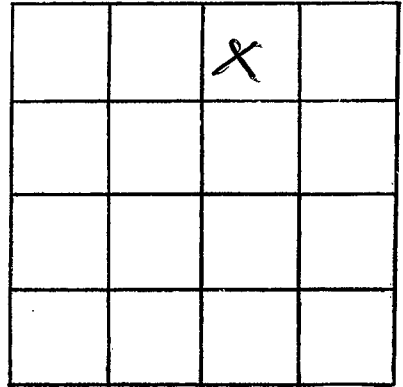

SECTION _____

Please indicate well location X.

ADDITIONAL INFORMATION

If more than one screen,
show locations of each on sketch.