

MISSISSIPPI DEPARTMENT OF NATURAL RESOURCES

Bureau of Land and Water Resources

Southport Mall

P.O. Box 10631

Jackson, Mississippi 39209

WATER WELL DRILLERS LOG

Pearl River
V 2075

4

July 28 1982 Braden Pump & Well Dr. Pearl River
 date well completed firm name county well located

LANDOWNER: Terry Miller
Box 511 A
Carrier, Miss. 39426
 (mailing address)

description of formations encountered	from	to
Surface	0	0
Red Clay	0	20
Blue Clay	20	140
Grey Sand	140	160
Blue Clay	160	+

WELL LOCATION:
 sec. 3 T S R 16
3 miles SE of McNeil
 (distance) (direction) (nearest town)

WELL PURPOSE: Home
 (home, irrigation, municipal, industrial)

WELL COMPLETION DATA:

(1) diameter (inches) 2"

(2) total depth (feet) 160

(3) static water level (feet) 60 below top of ground.

(4) casing PVC 150
 (material) (depth)
2" if telescope see back.
 (size)

(5) screen 10 ft 150
 (length) (depth to top)
2" PVC Under bar
 (size) (material)

(6) pump 1 1
 (HP) (yield gpm)
200W 1P
 (type power)

(7) electric log No
 (yes or no)

(organization running log)

(8) how well bottom plugged?
2 1/2 Sand Plug

DRILLERS REMARKS:


DEPT. OF NATURAL RESOURCES
 BUREAU OF LAND & WATER RESOURCES

JAN. 24 1983

RECEIVED

If well telescopes please sketch and show depths.

GROUND LEVEL

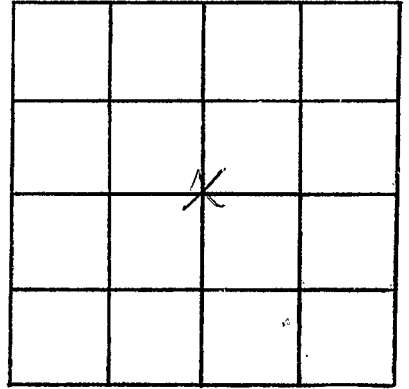

SECTION 3

Please indicate well location X.

ADDITIONAL INFORMATION

If more than one screen,
show locations of each on sketch.