

MISSISSIPPI DEPARTMENT OF NATURAL RESOURCES

Bureau of Land and Water Resources

Southport Mall

P.O. Box 10631

Jackson, Mississippi 39209

BUD PENTON & SON
WATER WELL SERVICE
ROUTE 4 BOX 502
CARRIER, MS 39426
PHONE 798-5324

WATER WELL DRILLERS LOG

BUD PENTON & SON
WATER WELL SERVICE
ROUTE 4 BOX 502
CARRIER, MS 39426
PHONE 798-5324

Pearl River
V
V2076

1/14 1983
date well completed

Pearl River
county well located

LANDOWNER: Leo E Carr

PT. 2 Box 305 A
Carrier Miss 39426
(mailing address)

description of formations encountered	from	to
<u>Red shale</u>	<u>0</u>	<u>80</u>
<u>Red sand</u>	<u>80</u>	<u>110</u>
<u>Blue shale</u>	<u>110</u>	<u>260</u>
<u>Blue sand</u>	<u>260</u>	<u>290</u>
<u>Blue shale</u>	<u>290</u>	<u>430</u>
<u>Red sand</u>	<u>430</u>	<u>471</u>

WELL LOCATION:

sec. 26 T. 5 N R. 16 E
S W
1/2 miles East of Carrier
(distance) (direction) (nearest town)

WELL PURPOSE: home
(home, irrigation, municipal, industrial)

WELL COMPLETION DATA:

- (1) diameter (inches) 2"
- (2) total depth (feet) 471
- (3) static water level (feet) 46 below top of ground.
- (4) casing PVC 471
(material) (depth)

_____ If telescope see back.
(size)

- (5) screen 2x10 461
(length) (depth to top)
1/2 PVC
(size) (material)
- (6) pump 1 1/2 460
(HP) (yield gpm)
Elect
(type power)

(7) electric log no
(yes or no)

_____ (organization running log)

(8) how well bottom plugged hard
shock

DRILLERS REMARKS:


DEPT. OF NATURAL RESOURCES
BUREAU OF LAND & WATER RESOURCES

APR 27 1983

RECEIVED

If well telescopes please sketch and show depths.

GROUND LEVEL

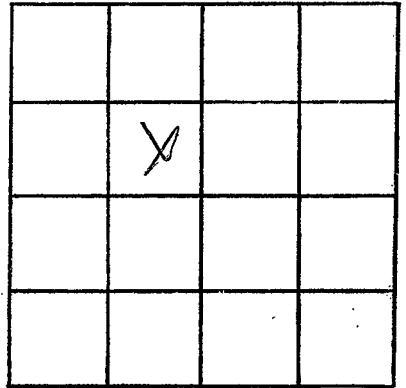

SECTION _____

Please indicate well location X.

ADDITIONAL INFORMATION

If more than one screen,
show locations of each on sketch.