

MISSISSIPPI DEPARTMENT OF NATURAL RESOURCES

Bureau of Land and Water Resources

Southport Mall

P.O. Box 10631

Jackson, Mississippi 39209

WATER WELL DRILLERS LOG

Paul River  
V 2077

June 10 1983 Walker Welding, Paul River  
date well completed firm name county well located

LANDOWNER:	Description of formations encountered	from	to
<u>Shady Stanford</u>	<u>White Chalk</u>	<u>0</u>	<u>14</u>
<u>Mc Neil Mill</u> (mailing address)	<u>sand</u>	<u>14</u>	<u>18</u>
WELL LOCATION:	<u>Blue shale</u>	<u>18</u>	<u>99</u>
sec. <u>2</u> T <u>5</u> S R <u>16</u> W	<u>Sand</u>	<u>99</u>	<u>135</u>
<u>3/4</u> miles <u>E</u> <u>McNeil</u>			
(distance) (direction) (nearest town)			
WELL PURPOSE: <u>Home</u>			
(home, irrigation, municipal, industrial)			
WELL COMPLETION DATA:			
(1) diameter (inches) <u>2"</u>			
(2) total depth (feet) <u>135'</u>			
(3) static water level (feet) <u>24</u> below top of ground.			
(4) casing <u>PVC</u> , <u>125'</u> (material) (depth)			
(size) If telescope see back.			
(5) screen <u>10"</u> , <u>125'</u> (length) (depth to top)			
<u>12</u> , <u>PVC</u> (size) (material)			
(6) pump <u>1</u> , <u>11</u> (HP) (yield gpm)			
<u>Electric</u> (type power)			
(7) electric log (yes or no)			
(organization running log)			
(8) how well bottom plugged <u>good</u> <u>Chalk</u>			
DRILLERS REMARKS:			


DEPT. OF NATURAL RESOURCES  
BUREAU OF LAND & WATER RESOURCES

JUN 14 1983

RECEIVED

If well telescopes please  
sketch and show depths.

GROUND LEVEL

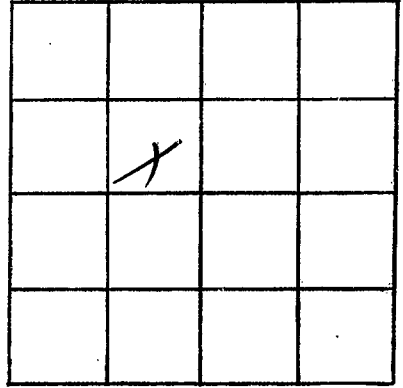

SECTION \_\_\_\_\_

Please indicate well location X.

ADDITIONAL INFORMATION

If more than one screen,  
show locations of each on sketch.