

MISSISSIPPI DEPARTMENT OF NATURAL RESOURCES

BUD FEIN Bureau of Land and Water Resources
 WATER WELL SERVICE
 ROUTE BOX 401 Southport Mall
 CARRIERS MO 39223 P.O. Box 10631
 PHONE 769-5924

Jackson, Mississippi 39209

WATER WELL DRILLERS LOG

WATER WELL SERVICE
 ROUTE BOX 401
 CARRIERS MO 39223
 PHONE 769-5924

Pearl River
 # V
 2081

10/8 1984
 date well completed

Pearl River
 county well located

LANDOWNER: Mike Shapiro

description of formations encountered

from to

A.T. 3 Box 203 Carriere

Red shale

0 30

Miss
 (mailing address)

Red sand

30 90

Blue shale

90 315

Gray sand

315 340

WELL LOCATION:

sec. 11 T 5 N R. 16 E
 S W
8 miles E of Carriere
 (distance) (direction) (nearest town)

WELL PURPOSE: home
 (home, irrigation, municipal, industrial)

WELL COMPLETION DATA:

- (1) diameter (inches) 2"
- (2) total depth (feet) 340
- (3) static water level (feet) 105 below above top of ground.
- (4) casing PVC, 340,
 (material) (depth)

_____ If telescope see back.
 (size)

- (5) screen 10, 330
 (length) (depth to top)

10, PVC
 (size) (material)

- (6) pump 1 1/2, 650
 (HP) (yield gpm)

E leaf
 (type power)

- (7) electric log no
 (yes or no)

_____ (organization running log)

- (8) how well bottom plugged sharp

DRILLERS REMARKS:


DEPT. OF NATURAL RESOURCES
 BUREAU OF LAND & WATER RESOURCES

DEC - 4 1984

RECEIVED

If well telescopes please sketch and show depths.

GROUND LEVEL

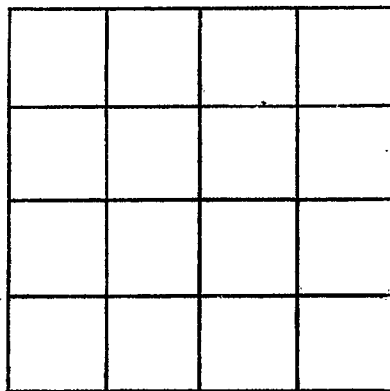

SECTION _____

Please indicate well location X.

ADDITIONAL INFORMATION

If more than one screen, show locations of each on sketch.