

MISSISSIPPI DEPARTMENT OF NATURAL RESOURCES

Bureau of Land and Water Resources

Southport Mall

P.O. Box 10631

Jackson, Mississippi 39209

WATER WELL DRILLERS LOG

Pearl River
V 2082

11/9 1984 Bud Penton Water Pearl River
date well completed firm name county well located
well service

LANDOWNER: Joe Wayland
R F - 2 Box 574
Carriere Miss -
(mailing address)

description of formations encountered	from	to
<u>Red shale</u>	<u>0</u>	<u>90</u>
<u>Blue shale</u>	<u>98</u>	<u>200</u>
<u>Gray sand</u>	<u>200</u>	<u>260</u>
<u>Blue shale</u>	<u>260</u>	<u>500</u>
<u>Gray sand</u>	<u>500</u>	<u>552</u>

WELL LOCATION:
sec. 7 T. 5 N. R. 16 E
S. W.
6 miles E of Carriere
(distance) (direction) (nearest town)

WELL PURPOSE: home
(home, irrigation, municipal, industrial)

WELL COMPLETION DATA:

- (1) diameter (inches) 4"
- (2) total depth (feet) 552
- (3) static water level (feet) 90 below above top of ground.
- (4) casing PVC, 552,
(material) (depth)
 if telescope see back.
(size)
- (5) screen 2x15, 537
(length) (depth to top)
10, PVC
(size) (material)
- (6) pump 1, 1350
(HP) (yield gpm)
Elect. 9PK
(type power)
- (7) electric log no
(yes or no)

(organization running log)

(8) how well bottom plugged hard
Mark


DRILLERS REMARKS:

DEPT. OF NATURAL RESOURCES
BUREAU OF LAND & WATER RESOURCES

DEC - 4 1984
RECEIVED

If well telescopes please sketch and show depths.

GROUND LEVEL

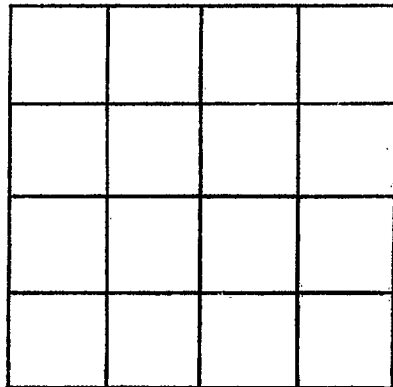

SECTION _____

Please indicate well location X.

ADDITIONAL INFORMATION

If more than one screen, show locations of each on sketch.