

MISSISSIPPI DEPARTMENT OF NATURAL RESOURCES

Bureau of Land and Water Resources

Southport Mall

P.O. Box 10631

Jackson, Mississippi 39209

WATER WELL DRILLERS LOG

Water Well Service

Rt. 4, Box 102

Carrier, Mississippi 39425

Pearl River
county well located

Pearl River
V 2085
4/25/85

4/25 1985
date well completed

LANDOWNER: Bill Bumpers
RT 4 Box 433 Carrier
Miss 39426
(mailing address)

Phone 601-798-5324

description of formations encountered

from	to
0	40
40	75
75	303

Red shale
Blue shale
Gray sand

WELL LOCATION:
sec. 10 T. 5 N R. 16 E
9 miles E of Carrier
(distance) (direction) (nearest town)

WELL PURPOSE: home
(home, irrigation, municipal, industrial)

WELL COMPLETION DATA:

- (1) diameter (inches) 9"
- (2) total depth (feet) 303
- (3) static water level (feet) 70 below above top of ground.
- (4) casing PVC, 303,
(material) (depth)
(size) if telescope see back.
- (5) screen 10, 293
(length) (depth to top)
12, PVC
(size) (material).
- (6) pump 1, 450 7.5
(HP) (yield gpm) gpm
Elect
(type power)
- (7) electric log no
(yes or no)

(organization running log)

(8) how well bottom plugged plugged
shale

DRILLERS REMARKS:


RECEIVED

JUN - 8 - 1985

Department of Natural Resources
Bureau of Land & Water Resources

If well telescopes please sketch and show depths.

GROUND LEVEL

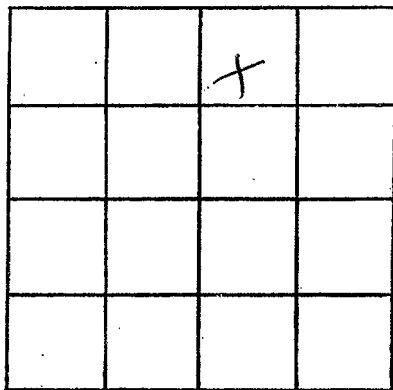

SECTION _____

Please indicate well location X.

ADDITIONAL INFORMATION

If more than one screen,
show locations of each on sketch.