

MISSISSIPPI DEPARTMENT OF NATURAL RESOURCES

Bureau of Land and Water Resources

Southport Mall

P.O. Box 10631

Jackson, Mississippi 39209

WATER WELL DRILLERS LOG

BUD PENTON & SONS

Water Well Service

Pearl River
county well located

PEARL RIVER
V 182088
6-11-85

6/11

1985

date well completed

firm name

county well located

LANDOWNER: Farid Shigpu
B.T. Carriere
(mailing address)

description of formations encountered	from	to
	<u>Red shale</u>	<u>0</u>
<u>Blue shale</u>	<u>25</u>	<u>185</u>
<u>blue sand</u>	<u>185</u>	<u>210</u>


WELL LOCATION:
sec. 5 T-31N R-16E
4 miles NE of Prigine
(distance) (direction) (nearest town)

WELL PURPOSE: home
(home, irrigation, municipal, industrial)

- WELL COMPLETION DATA:
- (1) diameter (inches) 2'
 - (2) total depth (feet) 210
 - (3) static water level (feet) 40 below above top of ground.
 - (4) casing PCC 210
(material) (depth)
70
(size) if telescope see back.
 - (5) screen 10 200
(length) (depth to top)
1/2 PCC
(size) (material)
 - (6) pump 1 650
(HP) (yield gpm)
Elect
(type power)
 - (7) electric log no
(yes or no)

(organization running log)
(8) how well bottom plugged plugged


DRILLERS REMARKS:

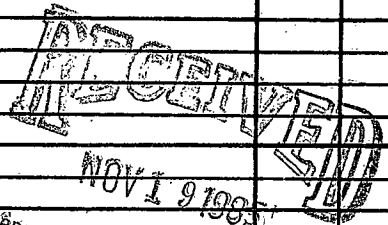

Department of Natural Resources
Bureau of Land & Water

If well telescopes please sketch and show depths.

GROUND LEVEL

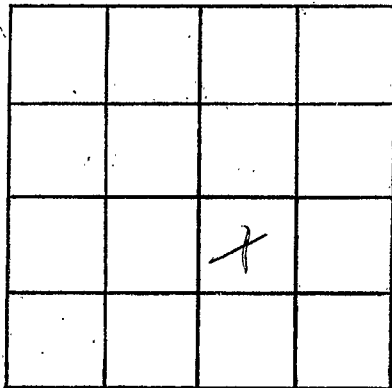

SECTION _____

Please indicate well location X.

ADDITIONAL INFORMATION

If more than one screen,
show locations of each on sketch.