

MISSISSIPPI DEPARTMENT OF NATURAL RESOURCES

Bureau of Land and Water Resources

Southport Mall

P.O. Box 10631

Jackson, Mississippi 39209

WATER WELL DRILLERS LOG

PEARL RIVER
V2089

3-7-86
date well completed

19 POUNCEY WATER WELL DRILLING
firm name

Pearl River
county well located

LANDOWNER: Mike Beach
Rt. 1
(mailing address)

WELL LOCATION:
sec. 3 T. 5 N R. 16 E
1 miles S of exit
(distance) (direction) (nearest town)

WELL PURPOSE: Home
(home, irrigation, municipal, industrial)

- WELL COMPLETION DATA:
- (1) diameter (inches) 2
 - (2) total depth (feet) 184
 - (3) static water level (feet) 16' below above top of ground
 - (4) casing (material) PVC (depth) 184
 - (size) 2 If telescope see back.
 - (5) screen (length) 10 (depth to top) 184
 - (size) 2 (material) PVC
 - (6) pump (HP) 1 1/2 (yield gpm) 10
 - (type power) AC
 - (7) electric log (yes or no)
 - (organization running log)
 - (8) how well bottom plugged Sealed


description of formations encountered	from	to
Top	0	30
SD	30	60
Blue	60	120
SD	120	184
SD good bottom	184	184

DRILLERS REMARKS:

MAR 9 1986
Bureau of Land and Water Resources
Natural Resources

If well telescopes please sketch and show depths.

GROUND LEVEL

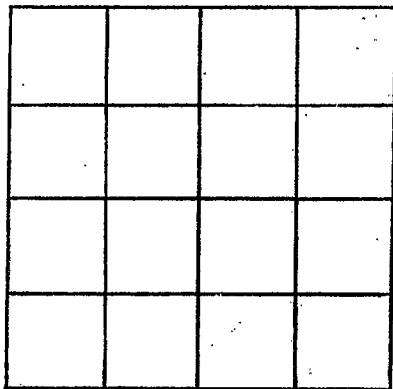

SECTION _____

Please indicate well location X.

ADDITIONAL INFORMATION

If more than one screen,
show locations of each on sketch.