

MISSISSIPPI DEPARTMENT OF NATURAL RESOURCES

Bureau of Land and Water Resources

Southport Mall

P.O. Box 10631

Jackson, Mississippi 39209

WATER WELL DRILLERS LOG

PEARL RIVER
V2090

4-15 1986 PENTON WELL SERV. PEARL RIVER
date well completed firm name county well located

LANDOWNER: ROBERT SMITH

description of formations encountered

from to

Hillcrest Road

CARRIERE MS. 39425
(mailing address)

Red Mud
Clay
SAND

0 90
90 250
250 327

WELL LOCATION:

sec. 10 T 5 R 16 E
4 miles EAST of CARRIERE
(distance) (direction) (nearest town)

WELL PURPOSE: HOME
(home, irrigation, municipal, industrial)

WELL COMPLETION DATA:

- (1) diameter (inches) 2"
- (2) total depth (feet) 327'
- (3) static water level (feet) 80 below top of ground.
- (4) casing PVC, 317'
(material) (depth)
2" if telescope see back.
(size)
- (5) screen 10', 317'
(length) (depth to top)
2" (size) PVC (material)
- (6) pump 1 (HP) (yield gpm)
Elec (type power)
- (7) electric log No (yes or no)

RECEIVED
MAY 20 1986

(organization running log)


(8) how well bottom plugged B.W

Department of Natural Resources
Bureau of Land & Water Resources

DRILLERS REMARKS:

If well telescopes please sketch and show depths.

GROUND LEVEL

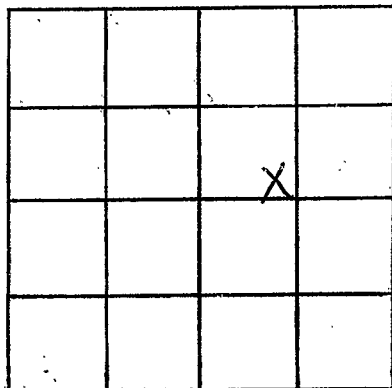

SECTION _____

Please indicate well location X.

ADDITIONAL INFORMATION

If more than one screen, show locations of each on sketch.