

MISSISSIPPI DEPARTMENT OF NATURAL RESOURCES

Bureau of Land and Water Resources

Southport Mall

P.O. Box 10631

Jackson, Mississippi 39209

WATER WELL DRILLERS LOG

POUNCEY WATER WELL DRILLING

Pearl River

PEARL RIVER  
V 2092

5-28 1982  
date well completed

firm name

county well located

LANDOWNER: Bruce

Anchor Lake Clean Rd.

(mailing address)

WELL LOCATION:

sec. 10 T 5 N R 16 E  
S W  
3 1/2 miles E of Carriere  
(distance) (direction) (nearest town)

WELL PURPOSE:

(home, irrigation, municipal, industrial)


WELL COMPLETION DATA:

- (1) diameter (inches) 2
- (2) total depth (feet) 352
- (3) static water level (feet) 130 below above top of ground.
- (4) casing PVC 342  
(material) (depth)  
2 If telescope see back.  
(size)
- (5) screen 10 342  
2 (length) (depth to top)  
(size) (material) PVC
- (6) pump 1 1/2 6  
(HP) (yield gpm)  
AC (type power)
- (7) electric log yes or no  
(organization running log)
- (8) how well bottom plugged Sealed

description of formations encountered

from to

Top	0	8
Shale	8	94
Clay	94	288
Shale Bottom	288	352

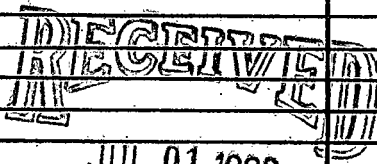


JUL 01 1996

Department of Natural Resources  
Bureau of Land and Water Resources

DRILLERS REMARKS:

If well telescopes please  
sketch and show depths.

GROUND LEVEL

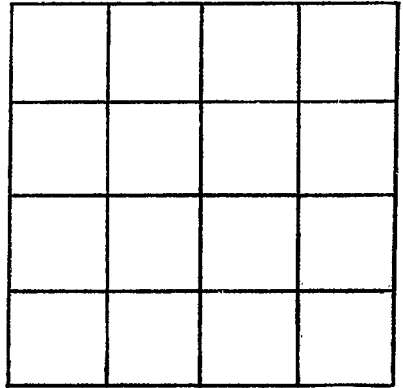

SECTION \_\_\_\_\_

Please indicate well location X.

ADDITIONAL INFORMATION

If more than one screen,  
show locations of each on sketch.