

MISSISSIPPI DEPARTMENT OF NATURAL RESOURCES
 Bureau of Land and Water Resources
 Southport Mall
 P.O. Box 10631
 Jackson, Mississippi 39209
WATER WELL DRILLERS LOG

PEARL RIVER
V2093

6/3 date well completed 1986 BUD PENTON firm name PEARL RIVER county well located

LANDOWNER: BILLY WHEAT
1360 PLASTINE
ROAD PICAYUNE MISS
 (mailing address)


description of formations encountered	from	to
<u>Red Shale</u>	<u>0</u>	<u>35</u>
<u>BLU E SHALE</u>	<u>35</u>	<u>300</u>
<u>Blue Sand</u>	<u>300</u>	<u>368</u>

WELL LOCATION:
 sec. 10 T. 5 N R. 16 E
^S WEST miles ^W EAST of CARRIERE
 (distance) (direction) (nearest town)

WELL PURPOSE: HOME
 (home, irrigation, municipal, industrial)


- WELL COMPLETION DATA:
- (1) diameter (inches) 2"
 - (2) total depth (feet) 368
 - (3) static water level (feet) 68 below top of ground.
 - (4) casing PVC, 368,
 (material) (depth)
 (size) if telescope see back.
 - (5) screen 10, 358
 (length) (depth to top)
12, PVC
 (size) (material)
 - (6) pump 710
 (HP) (yield gpm)
 (type power)
 - (7) electric log (yes or no)
 - (8) how well bottom plugged 710
sand shark

DRILLERS REMARKS: no pump furnished

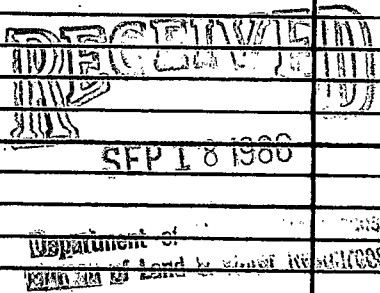

If well telescopes please sketch and show depths.

GROUND LEVEL

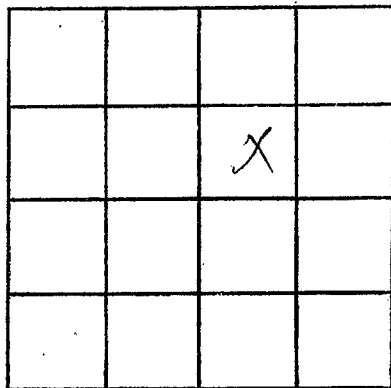

SECTION _____

Please indicate well location X.

ADDITIONAL INFORMATION

If more than one screen, show locations of each on sketch.