

MISSISSIPPI DEPARTMENT OF NATURAL RESOURCES

Bureau of Land and Water Resources

Southport Mall

P.O. Box 10631

Jackson, Mississippi 39209

WATER WELL DRILLERS LOG

BOUNCEY WATER WELL DRILLING

Keokuk River

PEARL RIVER
VADOK

9-4 1956
date well completed

firm name

county well located

LANDOWNER: *Denson Hans*

description of formations encountered

from to

Rt 3 Pci.

mp red clay

0 40

(mailing address)

sd

40 60

WELL LOCATION:

sec. *36* T. *5* N. R. *16* E.
S. W. *Keosau*

Blue clay

60 150

2 miles *S* of *Keosau*
(distance) (direction) (nearest town)

set.

150 230

WELL PURPOSE: *House*
(home, irrigation, municipal, industrial)

Set. Shale Clay

230 525

WELL COMPLETION DATA:

Fine sd to good coal

525 563

(1) diameter (inches) *4*

(2) total depth (feet) *563*

(3) static water level (feet) *68* below above top of ground.

(4) casing *PVC*, *348*,
(material) (depth)

(size) if telescope see back.

(5) screen *15*, *348*
(length) (depth to top)

(size) (material) *PVC*


(6) pump *30*
(HP) (yield gpm)

(type power)

(7) electric log (yes or no)

(organization running log)

(8) how well bottom plugged *Sealed*

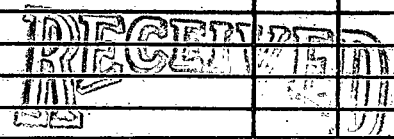


SEP 29 1956

DRILLERS REMARKS:

Department of Natural Resources
Bureau of Land and Water Resources
RECORDED
INDEXED

If well telescopes please sketch and show depths.

GROUND LEVEL

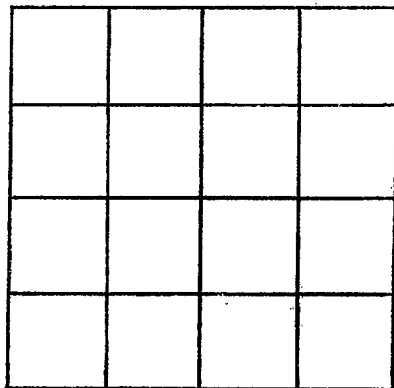

SECTION _____

Please indicate well location X.

ADDITIONAL INFORMATION

If more than one screen,
show locations of each on sketch.