

MISSISSIPPI DEPARTMENT OF NATURAL RESOURCES

Bureau of Land and Water Resources

Southport Mall

P.O. Box 10631

Jackson, Mississippi 39209

WATER WELL DRILLERS LOG

PEARL RIVER
V 2075

11/20 1986
date well completed

Bud Penton
firm name

Franklin
county well located

LANDOWNER: Margaret White

description of formations encountered

from to

Rt. 3 Box 46

Red Shell

0 30

Palmyra Twp 39466
(mailing address)

White Sand

30 70

Blue Shell

70 230

Gray Sand

230 275

WELL LOCATION:

sec. 13 T 5 N R 16 E
S W C
2 miles East of Palmyra
(distance) (direction) (nearest town)

WELL PURPOSE: Home
(home, irrigation, municipal, industrial)

WELL COMPLETION DATA:

- (1) diameter (inches) 2"
- (2) total depth (feet) 275
- (3) static water level (feet) 38 below above top of ground.
- (4) casing PVC, 275,
(material) (depth)

(size) If telescope see back.

- (5) screen 10, 265
(length) (depth to top)

12, PVC
(size) (material)

- (6) pump 1/2, 450
(HP) (yield gpm)


(type power)

- (7) electric log NO
(yes or no)

(organization running log)

- (8) how well bottom plugged Seal
Alaska

DRILLERS REMARKS:

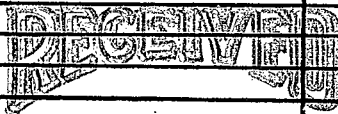

APR 21 1987

Department of Natural Resources
Bureau of Land & Water Resources

BUD PENTON & SONS

Water Well Service

Rt. 4, Box 402

Carriere, Mississippi 39426

Phone 601 - 798-5324

If well telescopes please sketch and show depths.

GROUND LEVEL

SECTION _____

Please indicate well location X.

ADDITIONAL INFORMATION

STATE OF CALIFORNIA
 DEPARTMENT OF WATER RESOURCES
 DIVISION OF WELL REGULATION
 WATER RIGHTS SECTION

If more than one screen, show locations of each on sketch.