

MISSISSIPPI DEPARTMENT OF NATURAL RESOURCES
 Bureau of Land and Water Resources
 Southport Mall
 P.O. Box 10631
 Jackson, Mississippi 39209
WATER WELL DRILLERS LOG

Pearl River
V 2000

11/21 1986 Bed Penton Water Pearl River
 date well completed firm name county well located

LANDOWNER: Curtis Coates
PO Box 529 Carriere
Miss 39426
 (mailing address)

description of formations encountered	from	to
<u>Bed Shell</u>	<u>0</u>	<u>65</u>
<u>Blue Shell</u>	<u>65</u>	<u>375</u>
<u>Grey Sand</u>	<u>375</u>	<u>410</u>

WELL LOCATION:
 sec. 15 T. 5 N R. 16 E
6 miles East of Carriere
 (distance) (direction) (nearest town)

WELL PURPOSE: Home
 (home, irrigation, municipal, industrial)

- WELL COMPLETION DATA:
- diameter (inches) 2"
 - total depth (feet) 410
 - static water level (feet) 60 below above top of ground.
 - casing PVC, 410
 (material) (depth)
 (size) if telescope see back.
 - screen 10, 400
 (length) (depth to top)
1/2, PVC
 (size) (material)
 - pump 1, 650
 (HP) (yield gpm)
 (type power)
 - electric log no
 (yes or no)
 (organization running log)
 - how well bottom plugged Good
Mark

RECEIVED

APR 21 1987


Department of Natural Resources
 Bureau of Land & Water Resources

BUD PENTON & SONS
 Water Well Service
 Rt. 4, Box 402
 Carriere, Mississippi 39426
 Phone 601 - 798-5324

DRILLERS REMARKS:

If well telescopes please sketch and show depths.

GROUND LEVEL

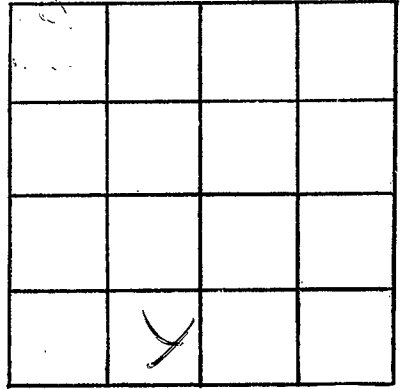

SECTION _____

Please indicate well location X.

ADDITIONAL INFORMATION

If more than one screen,
show locations of each on sketch.