

MISSISSIPPI DEPARTMENT OF NATURAL RESOURCES

Bureau of Land and Water Resources

Southport Mall

P.O. Box 10631

Jackson, Mississippi 39209

WATER WELL DRILLERS LOG

Leah Green
W 2097

1/16/87 19 87
 date well completed

Bud Penton
 firm name

Pearl River
 county well located

Watts Well

LANDOWNER: Robert Jones
R.F. 2 Box 246
Pilgrimage TN 39466
 (mailing address)


description of formations encountered	from	to
	<u>Red shale</u>	<u>0</u>
<u>Red sand</u>	<u>60</u>	<u>80</u>
<u>Blue shale</u>	<u>80</u>	<u>572</u>
<u>Gray sand</u>	<u>572</u>	<u>595</u>

WELL LOCATION:
 sec. 12 T. 5 N R. 16 E
8 miles East of Pilgrimage
 (distance) (direction) (nearest town)

WELL PURPOSE: home
 (home, irrigation, municipal, industrial)

WELL COMPLETION DATA:

- (1) diameter (inches) 4
- (2) total depth (feet) 595
- (3) static water level (feet) 40 below top of ground.
- (4) casing PVC, 595
 (material) (depth)
 (size) If telescope see back.
- (5) screen 10, 585
 (length) (depth to top)
12, PVC
 (size) (material)
- (6) pump 1, 1200
 (HP) (yield gpm)
Elect
 (type power)
- (7) electric log no
 (yes or no)
 (organization running log)
- (8) how well bottom plugged and
mark

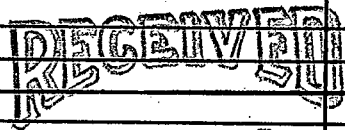


JUN 12 1987

Department of Natural Resources
 Bureau of Land & Water Resources

DRILLERS REMARKS:

If well telescopes please sketch and show depths.

GROUND LEVEL

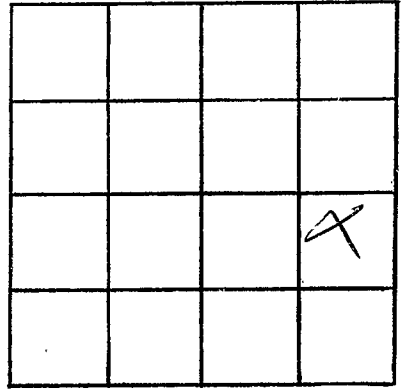

SECTION _____

Please indicate well location X.

ADDITIONAL INFORMATION

If more than one screen,
show locations of each on sketch.