

MISSISSIPPI DEPARTMENT OF NATURAL RESOURCES

Bureau of Land and Water Resources

Southport Mall

P.O. Box 10631

Jackson, Mississippi 39209

WATER WELL DRILLERS LOG

Bear River
M 2078

9/30-86
 date well completed

Budpenon Water Well
 firm name

Jackson
 county well located

LANDOWNER: Mike Whitfield

description of formations encountered

from to

Rt. 2 Box 347 B

Red shale

0 30

Carriere miss.
 (mailing address)

Red sand

30 65

Blue shale

65 200

Grey sand

200 275

Blue shale

275 370

Grey sand

370 445


WELL LOCATION:

sec. 10 T 5 N R 16 E
 S W

4 miles East of Carriere
 (distance) (direction) (nearest town)

WELL PURPOSE: home
 (home, irrigation, municipal, industrial)

WELL COMPLETION DATA:

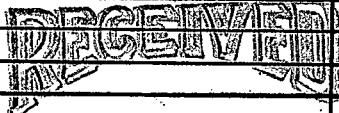

JUN 12 1987

Department of Natural Resources
 Bureau of Land & Water Resources

(1) diameter (inches) 2"

(2) total depth (feet) 445

(3) static water level (feet) 70 below above top of ground.

(4) casing PVC, 405
 (material) (depth)

_____ if telescope see back.
 (size)

(5) screen 2x10, 405
 (length) (depth to top)

1 1/2, PVC
 (size) (material)

(6) pump no
 (HP) (yield gpm)

_____ (type power)

(7) electric log _____
 (yes or no)

_____ (organization running log)

(8) how well bottom plugged good
short

DRILLERS REMARKS:

If well telescopes please sketch and show depths.

GROUND LEVEL

X			

SECTION _____

Please indicate well location X.

ADDITIONAL INFORMATION

If more than one screen, show locations of each on sketch.