

MISSISSIPPI DEPARTMENT OF NATURAL RESOURCES

Bureau of Land and Water Resources

Southport Mall

P.O. Box 10631

Jackson, Mississippi 39209

WATER WELL DRILLERS LOG

Pearl River
 V 200

8/3 1987
 date well completed

Bub Penton
 firm name

Pearl River
 county well located

LANDOWNER: <u>Michel Bennett</u>	description of formations encountered	from	to
<u>R.T-1 Carrer</u>	<u>Red shale</u>	<u>0</u>	<u>15-</u>
<u>Miss-</u>	<u>White sand</u>	<u>15-</u>	<u>58-</u>
(mailing address)	<u>Blue shale</u>	<u>58-</u>	<u>295-</u>
	<u>Blue sand</u>	<u>295-</u>	<u>343</u>

WELL LOCATION:
 sec. 24 T 9S R 18E
3 miles East of Carrer
 (distance) (direction) (nearest town)

WELL PURPOSE: none
 (home, irrigation, municipal, industrial)

- WELL COMPLETION DATA:
- (1) diameter (inches) 2
 - (2) total depth (feet) 343
 - (3) static water level (feet) 12 below above top of ground.
 - (4) casing PVC, 343
 (material) (depth)
20 if telescope see back.
 (size)
 - (5) screen 10, 333
 (length) (depth to top)
12, PVC
 (size) (material)
 - (6) pump no
 (HP) (yield gpm)
 (type power)
 - (7) electric log no
 (yes or no)
 (organization running log)
 - (8) how well bottom plugged hard

RECEIVED


AUG 13 1987

Department of Natural Resources
 Bureau of Land & Water Resources

DRILLERS REMARKS:

If well telescopes please sketch and show depths.

GROUND LEVEL

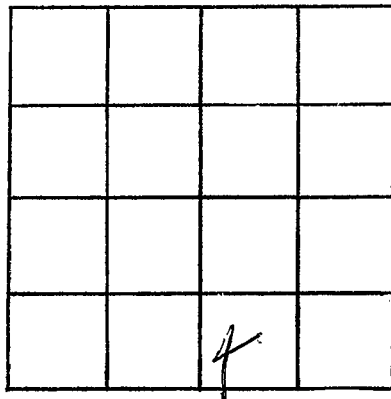

SECTION _____

Please indicate well location X.

ADDITIONAL INFORMATION

If more than one screen,
show locations of each on sketch.