

MISSISSIPPI DEPARTMENT OF NATURAL RESOURCES

Bureau of Land and Water Resources

Southport Mall

P.O. Box 10631

Jackson, Mississippi 39209

WATER WELL DRILLERS LOG

Pearl River
VAD

9/18

date well completed

ST Bend Penton

firm name

Water Well Service

Pearl River

county well located

LANDOWNER:

Tom Smith

description of formations encountered

from

to

RT-1 Carrier

Red Shell

0 25

Red Sand

25 40

Blue Shale

40 235

Gray Sandstone

235 295

Blue Shell

295 320

Gray Sand

320 576

Miss

(mailing address)

WELL LOCATION:

sec. 14 T 5 N R 16 E

S

W

3

miles

Swest of Carrier

(distance)

(direction)

(nearest town)

WELL PURPOSE:

home

(home, irrigation, municipal, industrial)

WELL COMPLETION DATA:

(1) diameter (inches)

9"

(2) total depth (feet)

576

(3) static water level (feet) 75 below above top of ground.

(4) casing

PVC

566

(material)

(depth)

70

(size)

if telescope see back.

(5) screen

10

566

(length)

(depth to top)

12

(size)

PVC

(material)

(6) pump

1

(HP)

630

(yield gpm)

Ebet

(type power)

(7) electric log

no

(yes or no)

(organization running log)

(8) how well bottom plugged

stand spars

DRILLERS REMARKS:


RECEIVED

APR 1 1988

Department of Natural Resources
 Bureau of Land & Water Resources

If well telescopes please sketch and show depths.

GROUND LEVEL

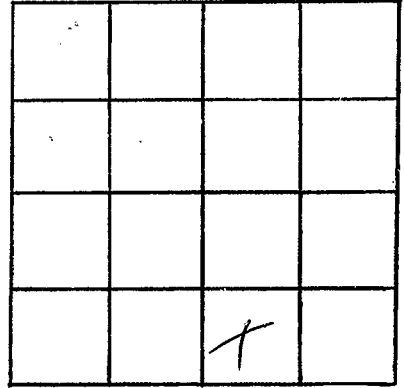

SECTION _____

Please indicate well location X.

ADDITIONAL INFORMATION

If more than one screen,
show locations of each on sketch.