

MISSISSIPPI DEPARTMENT OF NATURAL RESOURCES

Bureau of Land and Water Resources

P.O. Box 10631

Jackson, Mississippi 39209

WATER WELL DRILLERS LOG

COUNTY WELL LOCATED  
*Pearl River*  
 WELL NUMBER  
*V2102*  
 CODED  
 DATE WELL COMPLETED  
*4-27-88*

PERMIT NUMBER  
**POUNCEY WATER WELL DRILLING**

NAME OF DRILLING COMPANY  
*NOTE 3, BOX 461  
 PICAYUNE, MS. 39466*

NAME & MAILING ADDRESS OF LANDOWNER  
*Cpt. Peter Toff  
 Canton Comm.*  
 WELL LOCATION: SEC TOWNSHIP RANGE  
*1 5 N 16 E W*  
 DISTANCE DIRECTION NEAREST TOWN  
*3 Miles N of Canton*  
 OTHER LANDMARK  
*North Side Horned  
 Lurpkin Place*  
 WELL PURPOSE: Home, Irrigation, Municipal, Industrial, Fish Pond, etc.  
*Lurpkin Place*

PUMP DATA  
 PUMP TYPE (Circle One):  
 Submersible, Turbine, Jet, Flowing Well,  
 Other (Describe) \_\_\_\_\_  
 POWER TYPE (Circle One):  
 Electric, Tractor, Diesel, Gasoline, Butane,  
 Other (Describe) \_\_\_\_\_  
 Pump Capacity (GPM) No. of Stages Setting Depth  
*200 200 100* FT.  
 PUMP TEST  
 Well yielded *70* GPM with  
 a drawdown of \_\_\_\_\_ ft.  
 after \_\_\_\_\_ hours of pumping

WELL DATA  
 Well Depth Casing Diameter (In.) Casing Length (Ft.)  
*232 4 217*  
 Type of Casing Hole Depth Depth to Static Water Level  
*PVC 232 81'*  
 TYPE OF COMPLETION: (Circle One or More):  
 Gravel Packed,  Underreamed,  Telescoped,  
 Natural Development,  Open Hole,  Other  
 (Describe) \_\_\_\_\_  
 Top of Lap Pipe or Reduction in Casing  
 FEET IF TELESKOPED OR MORE THAN ONE SCREEN: USE BACK PAGE

LOG DATA  
 TYPE OF LOG RUN (Circle One): No Log Run, Electric, Gamma Ray, Density, Sonic, Neutron, Other (Describe) \_\_\_\_\_  
 Name of Organization Running Log

SCREEN DATA  
 Diameter - Inches Length - Feet Slot Size - Inches  
*4" 15 008*  
 Screen Type Depth to Bottom - Feet  
*PVC Wrap 232*

GEOLOGIC DATA (Office Use Only)

Surface Elev.	Geologic Unit	Unit Thickness	Depth to Top
Subs. SWL	Date	Analysis	Aquifer Test

Driller's Remarks  
*Well - for Toff  
 Line fish farm*

DESCRIPTION OF FORMATIONS ENCOUNTERED	FROM	TO	FORMATIONS (Continued)	FROM	TO
<i>top</i>	<i>0</i>	<i>6</i>	<b>RECEIVED</b> <b>MAY 16 1988</b> Department of Natural Resources Bureau of Land & Water Resources		
<i>clay</i>	<i>6</i>	<i>18</i>			
<i>SD</i>	<i>18</i>	<i>40</i>			
<i>clay</i>	<i>40</i>	<i>141</i>			
<i>st to good SD.</i>	<i>141</i>	<i>232</i>			


IF MORE SPACE IS NEEDED, USE BACK

If well telescopes please  
sketch and show depths.

---

GROUND LEVEL

---

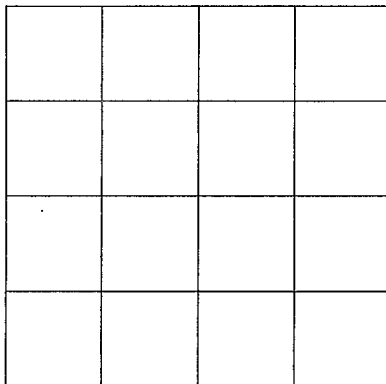

SECTION \_\_\_\_\_

Please indicate well location X.

---

ADDITIONAL INFORMATION

---

If more than one screen,  
show location of each on sketch.

---