

MISSISSIPPI DEPARTMENT OF NATURAL RESOURCES
Bureau of Land and Water Resources
 Southport Mall
 P.O. Box 10631
 Jackson, Mississippi 39209
WATER WELL DRILLERS LOG

P. Riven
✓ 2105

5/20 1988 Bud Penton & Son Jard River
 date well completed firm name county well located

LANDOWNER: Terrell Bennett
PO Box 527 Carriere
Miss. 39426
 (mailing address)

description of formations encountered	from	to
	<u>Red shale</u>	<u>0</u>
<u>White sand</u>	<u>21</u>	<u>60</u>
<u>Blue shale</u>	<u>60</u>	<u>376</u>
<u>Gravel sand</u>	<u>376</u>	<u>443</u>

WELL LOCATION:
 sec. 3 T. 5 N R. 16 E
 S W
5 miles East of Carriere
 (distance) (direction) (nearest town)

WELL PURPOSE: home
 (home, irrigation, municipal, industrial)

WELL COMPLETION DATA:

- (1) diameter (inches) 2"
- (2) total depth (feet) 443
- (3) static water level (feet) 5' below above top of ground.
- (4) casing pvc 438
 (material) (depth)
 _____ if telescope see back.
 (size)
- (5) screen 15" 438
 (length) (depth to top)
12" pvc
 (size) (material)
- (6) pump no
 (HP) (yield gpm)
 _____ (type power)
- (7) electric log no
 (yes or no)
 _____ (organization running log)
- (8) how well bottom plugged sand
shut

DRILLERS REMARKS: _____


RECEIVED

JUN 16 1988

Department of Natural Resources
 Bureau of Land & Water Resources

If well telescopes please sketch and show depths.

GROUND LEVEL

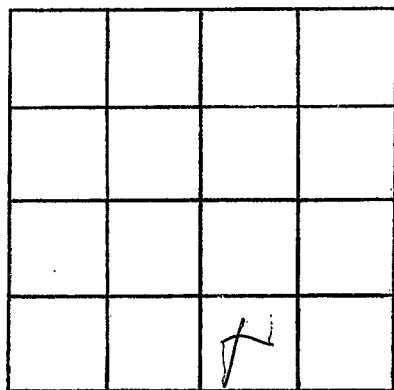

SECTION _____

Please indicate well location X.

ADDITIONAL INFORMATION

If more than one screen,
show locations of each on sketch.